


# T.13 S. R.3 W.W.M.

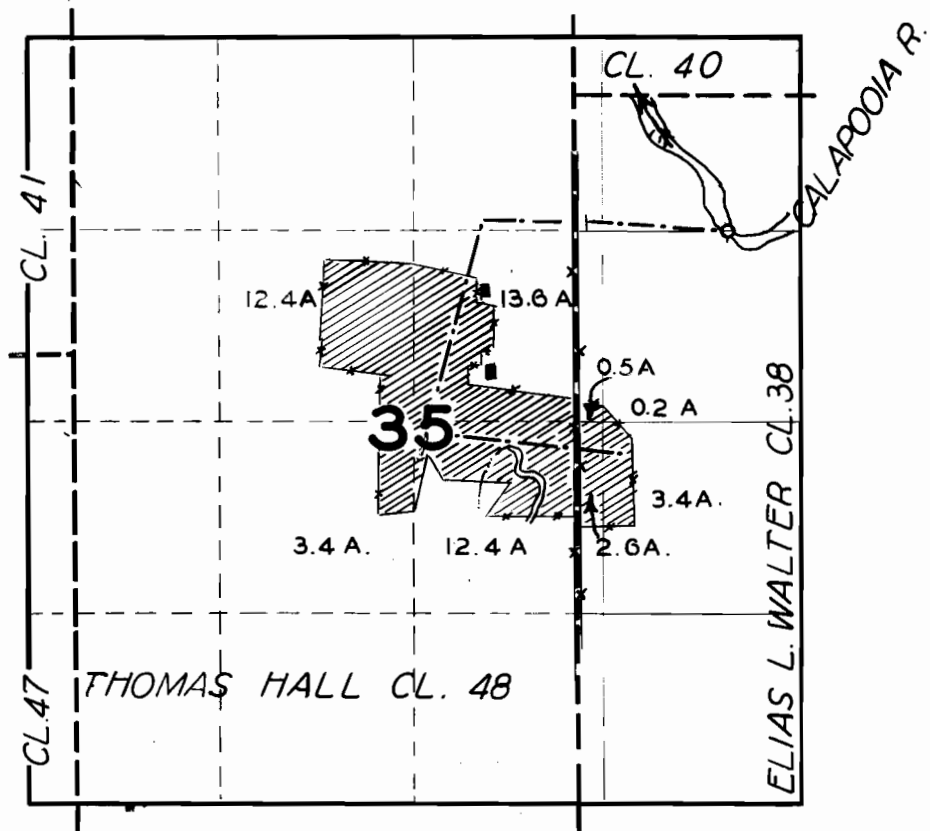

## FINAL PROOF SURVEY

UNDER

Application No. 24583 Permit No. 19327

IN NAME OF

R. A. WARD

Surveyed APR. 23, 1951, by H. L. COFFMAN