


T. 1 S. R. 2 W. W. M.

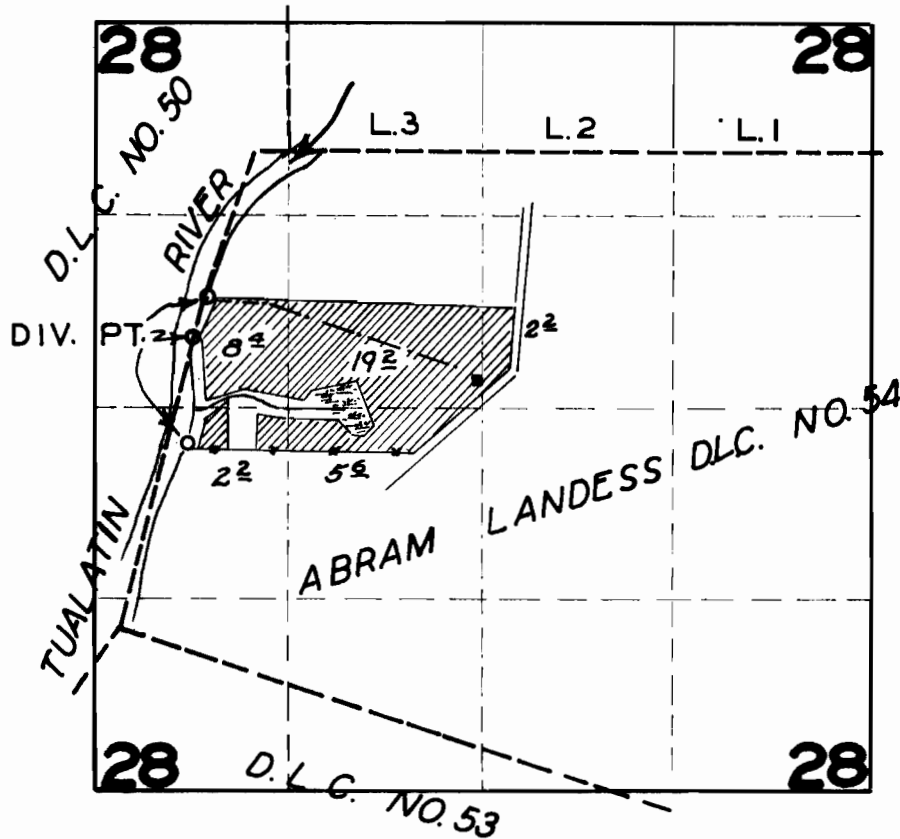

FINAL PROOF SURVEY

UNDER

Application No. 23170... Permit No. 18252..

IN NAME OF

V. H. VAN DEHEY

Surveyed 7/9..... 1951., by H. L. COFFMAN