


T.4S. R.4W.W.M.

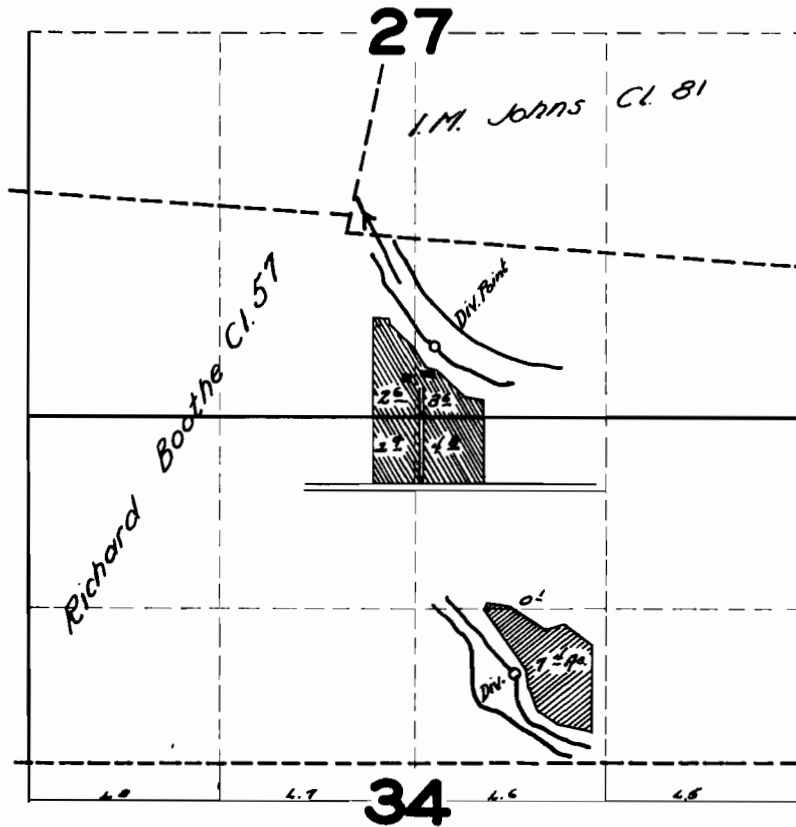

FINAL PROOF SURVEY

UNDER

ELMER B. DILLON APP. 24319 PER. 19063



MRS. N. ROMEIKE APP. 24753 PER. 19516



Surveyed 9 / 20 1951, by H.L. COFFMAN