



T.3S.R.4W.W.M.

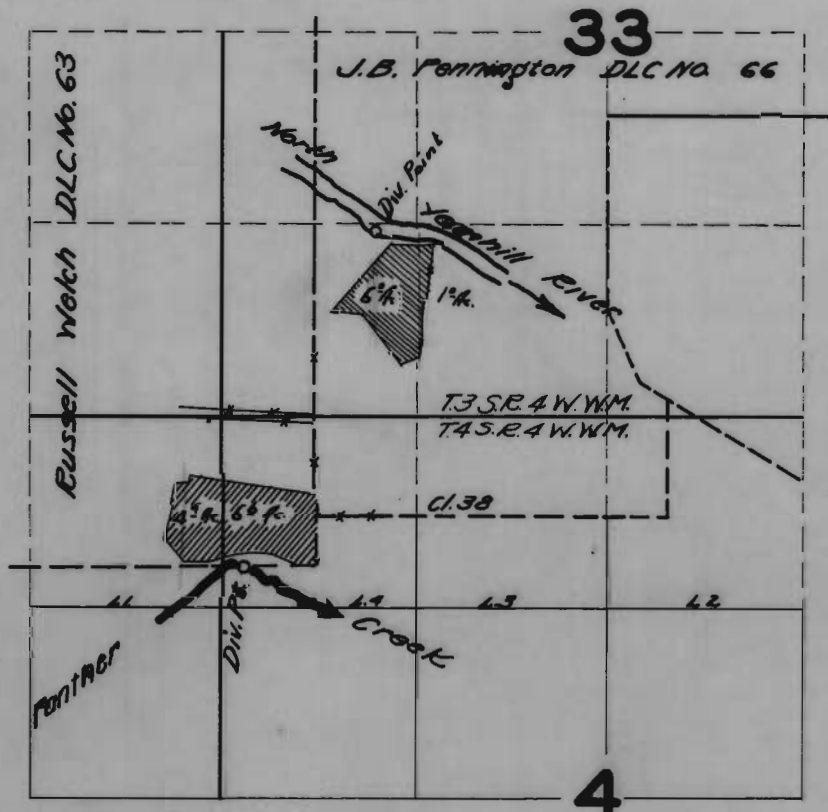

APP. 24657 PER. 19562 

FINAL PROOF SURVEY

UNDER

24657

19562

Application No. 25158 Permit No. 19788

IN NAME OF

CHARLES E. SITTON

Surveyed 10/10 1951., by H.L. COFFMAN.