


19691
19913

T.39 S.R. 10 E.W.M.

Best Price Misc.

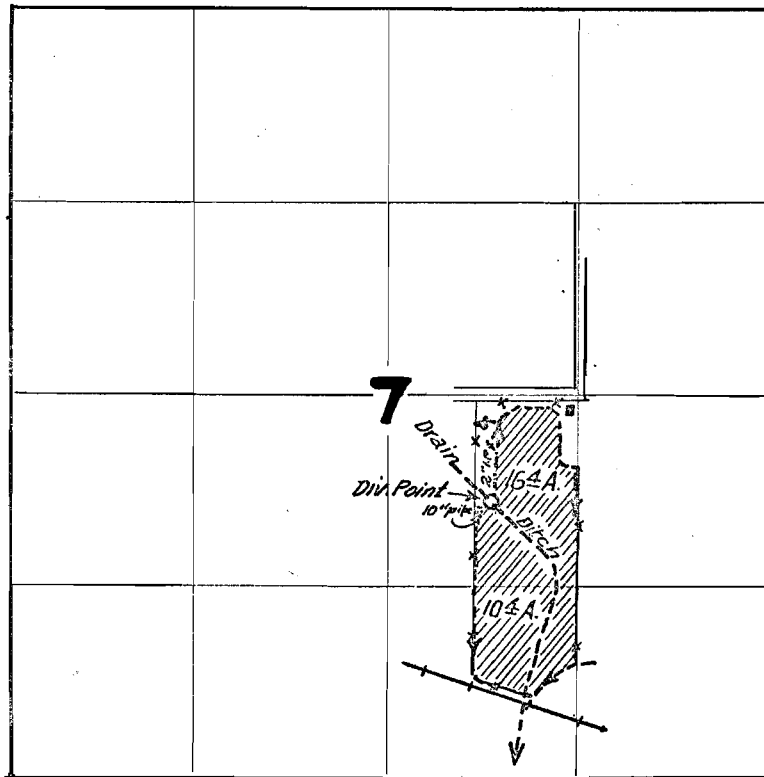

FINAL PROOF SURVEY UNDER

Application No. 24933 Permit No. 19691
IN NAME OF

HARRY BOOTH

Surveyed MAY 15 1951, by H.L. COFFMAN