

SECTION

4
9
16
17


14662
1994

map 1

TOWNSHIP 40 S, RANGE 22 E W. M.

North

39 ac

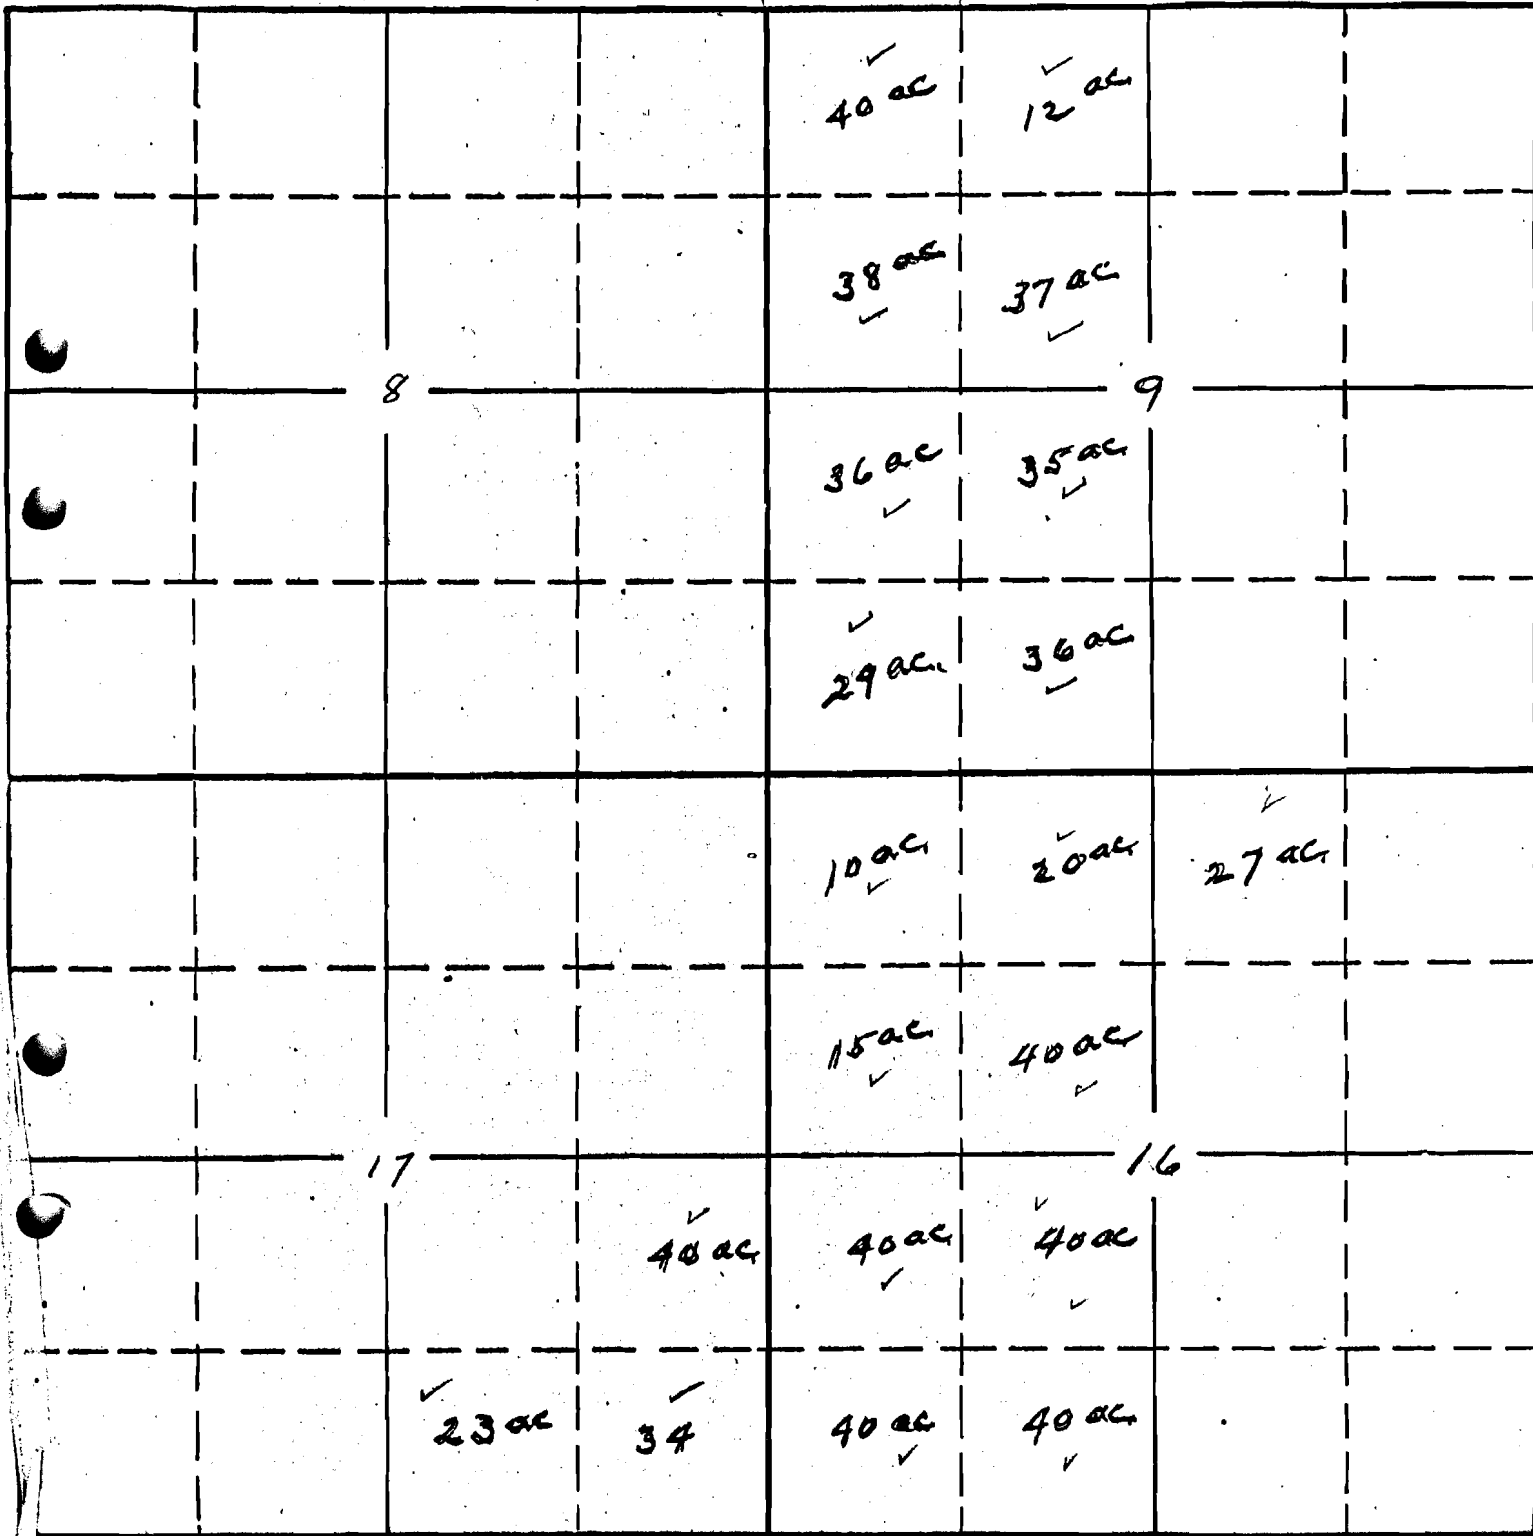

South

19066
13-43

APPLICATION No. 19066
PERMIT No. 14662

40-22 ✓

RECEIVED

JUN 28 1940

STATE ENGINEER
SALEM, OREGON


14662

Map 2

SECTION
15
22

TOWNSHIP 40 S., RANGE 22 E., W. M.

North

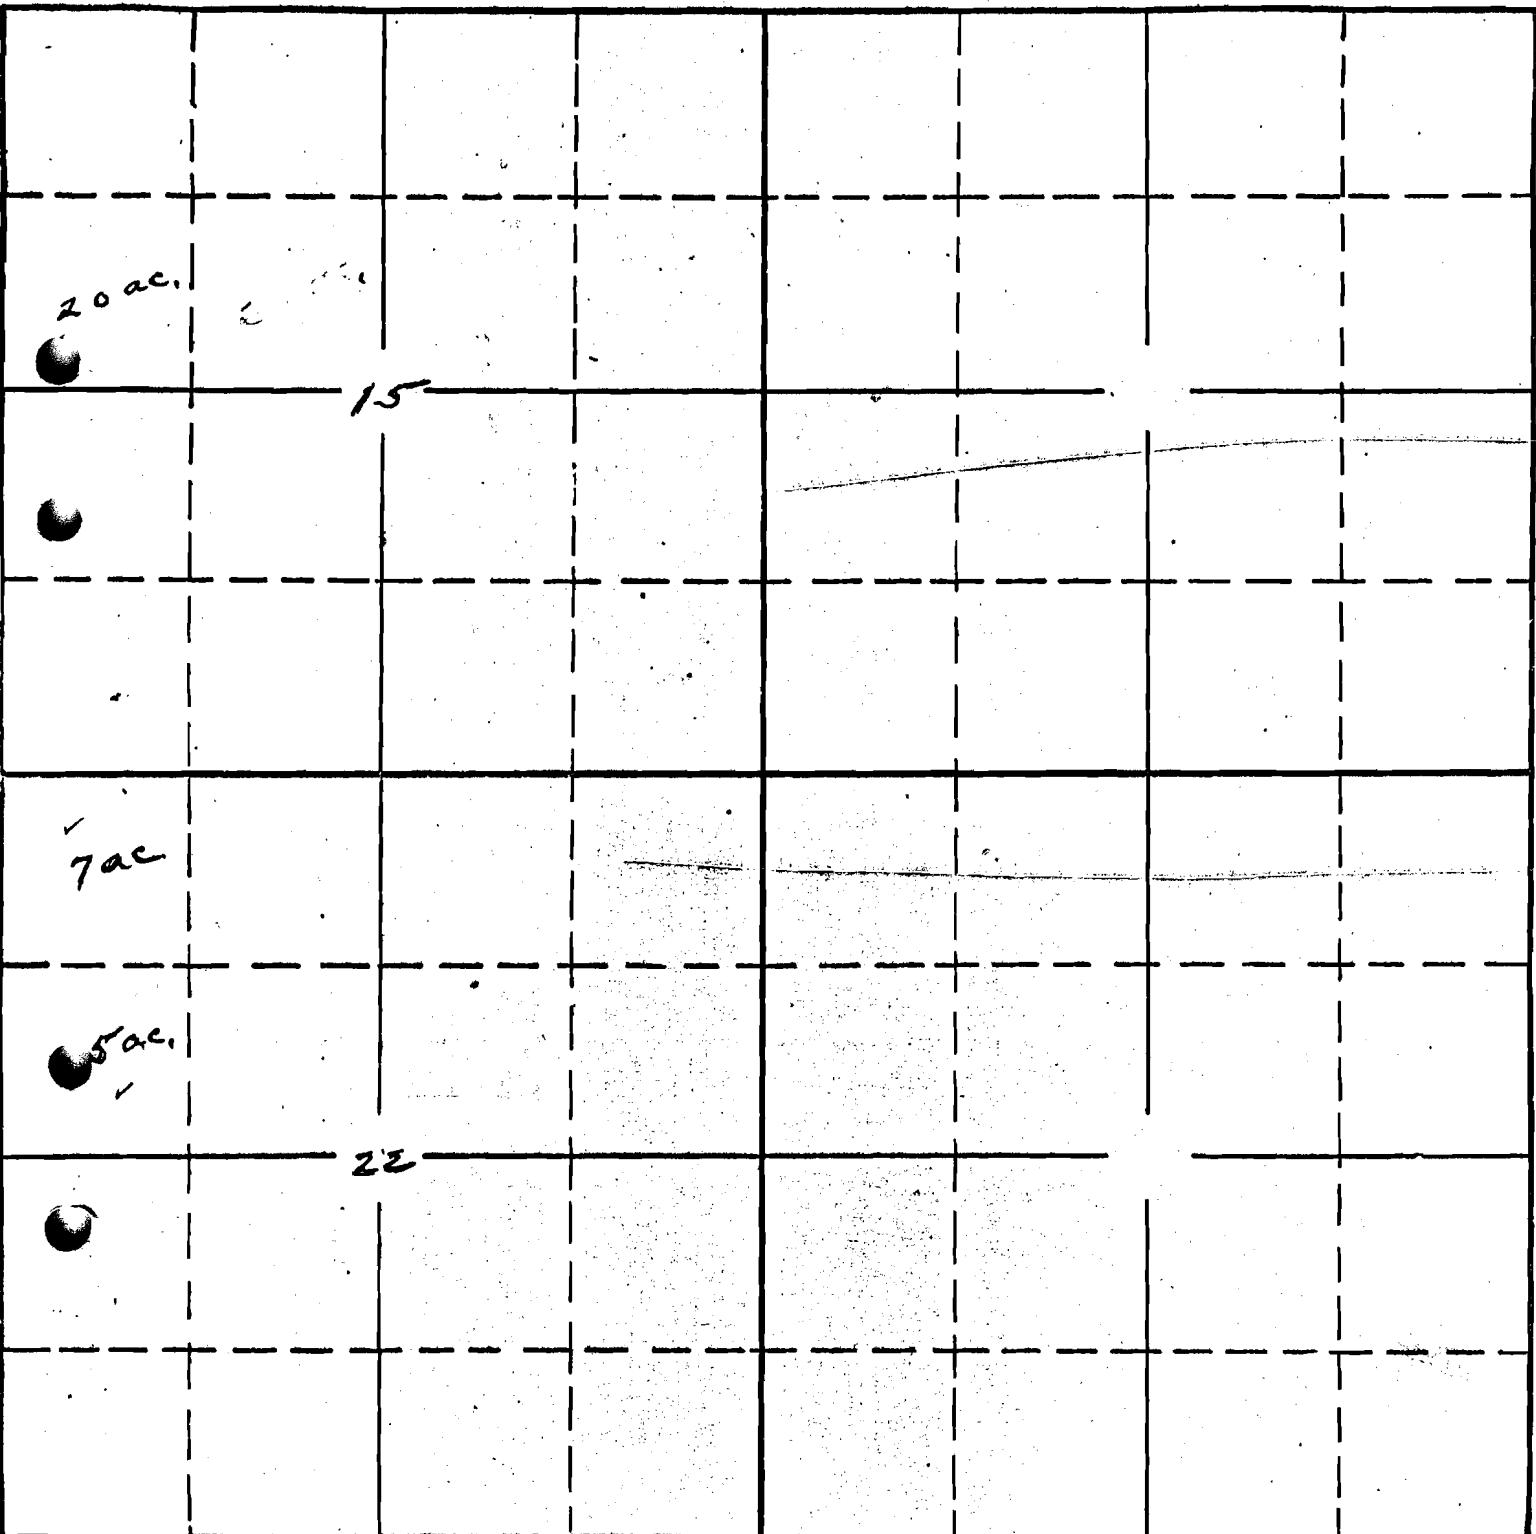

South

19066

RECEIVED
OCT 28 1940
STATE ENGINEER
SALEM, OREGON

APPLICATION No. 19066
PERMIT No. 14662

40-22 ✓


SECTION

- 20
- 21
- 29
- 28

14662

Map 3

TOWNSHIP 40S, RANGE 22E, W. M.

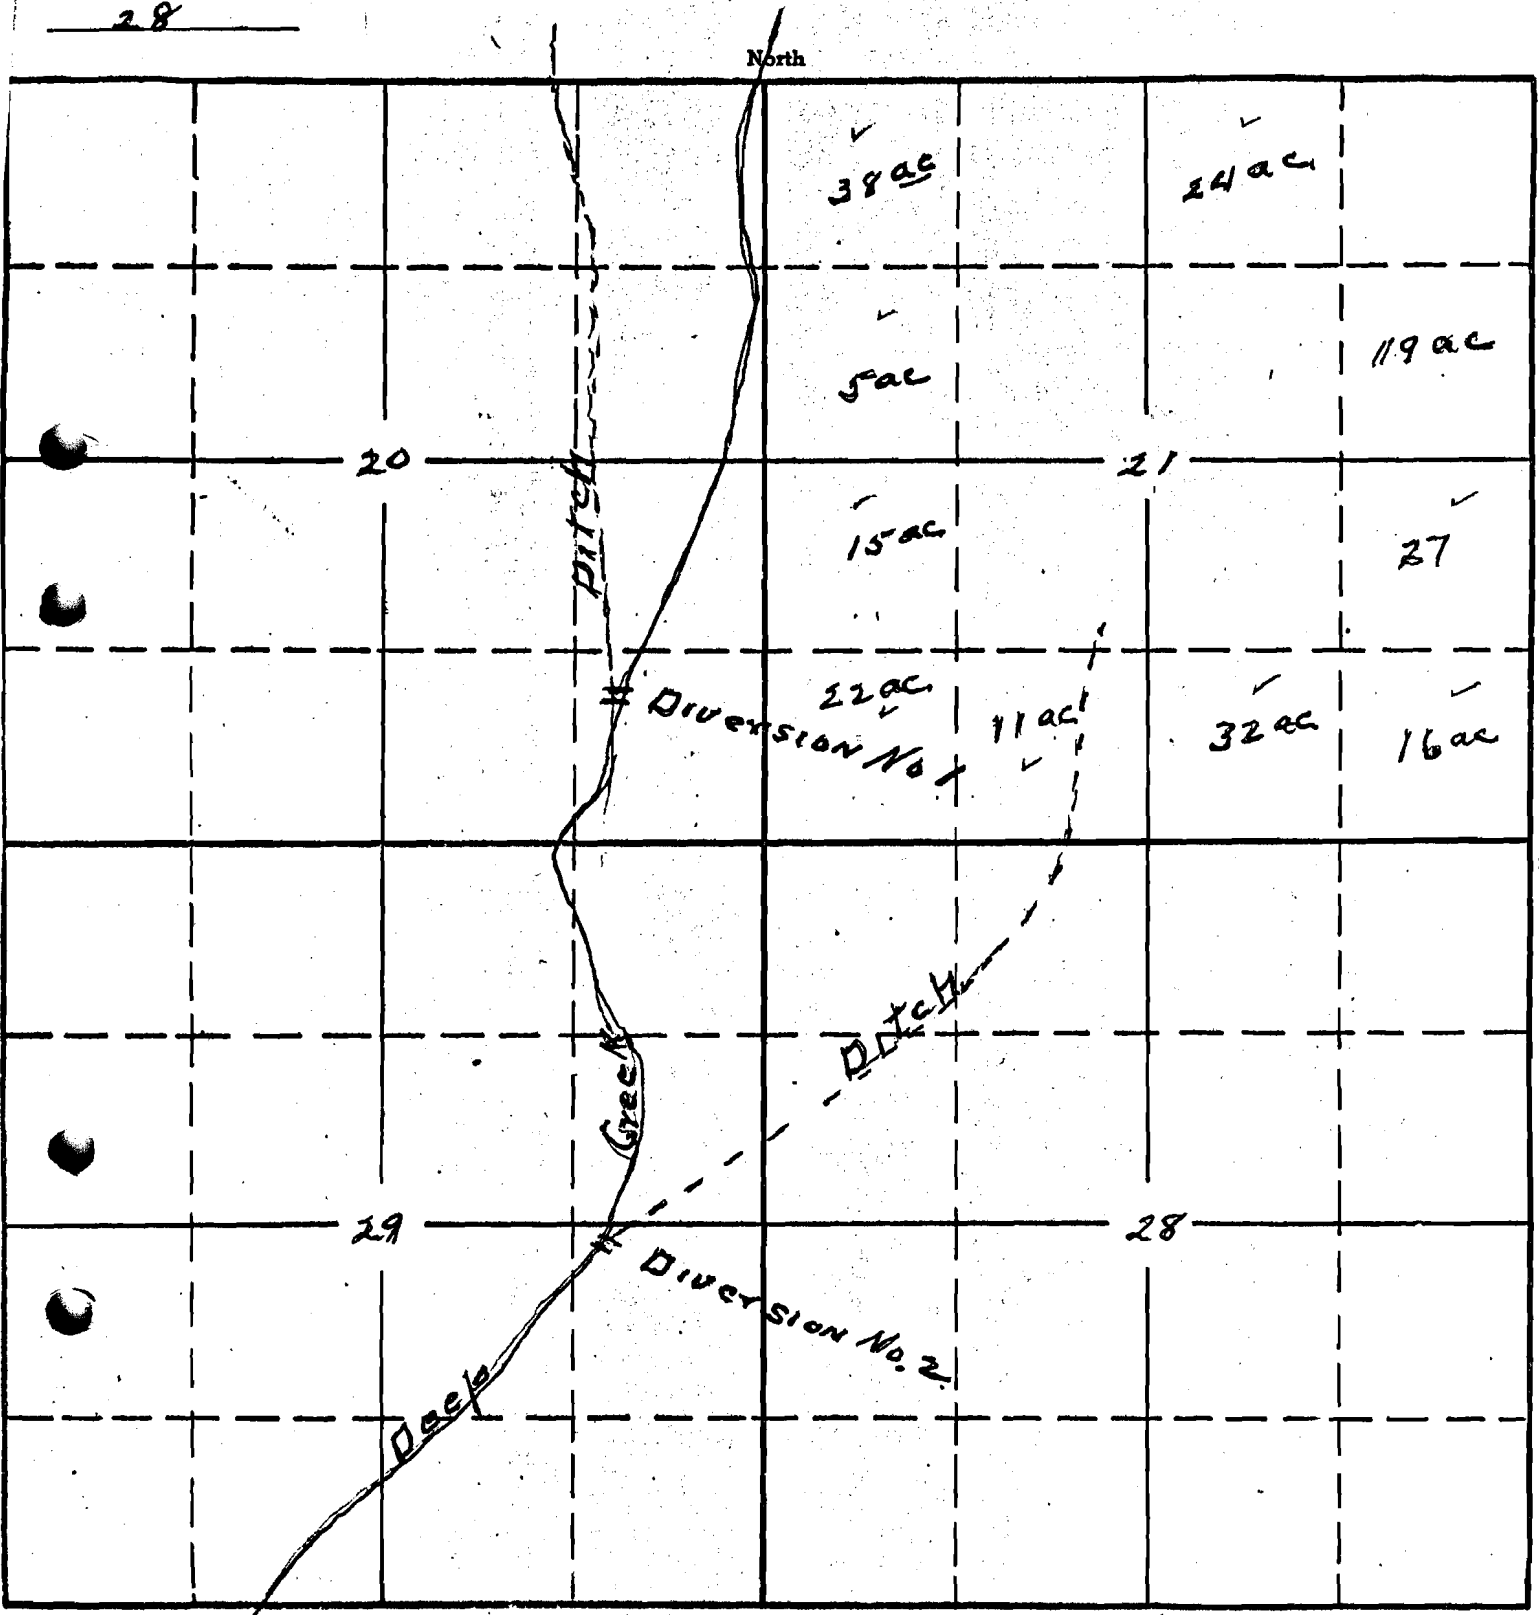

RECEIVED
 OCT 23 1940
 STATE ENGINEER

19066 07C
 13-43
 APPLICATION No. 19066
 PERMIT No. 14662

40-220