

SECTION

5


8

14664

19916

TOWNSHIP 40 S, RANGE 22 E, W. M.

North

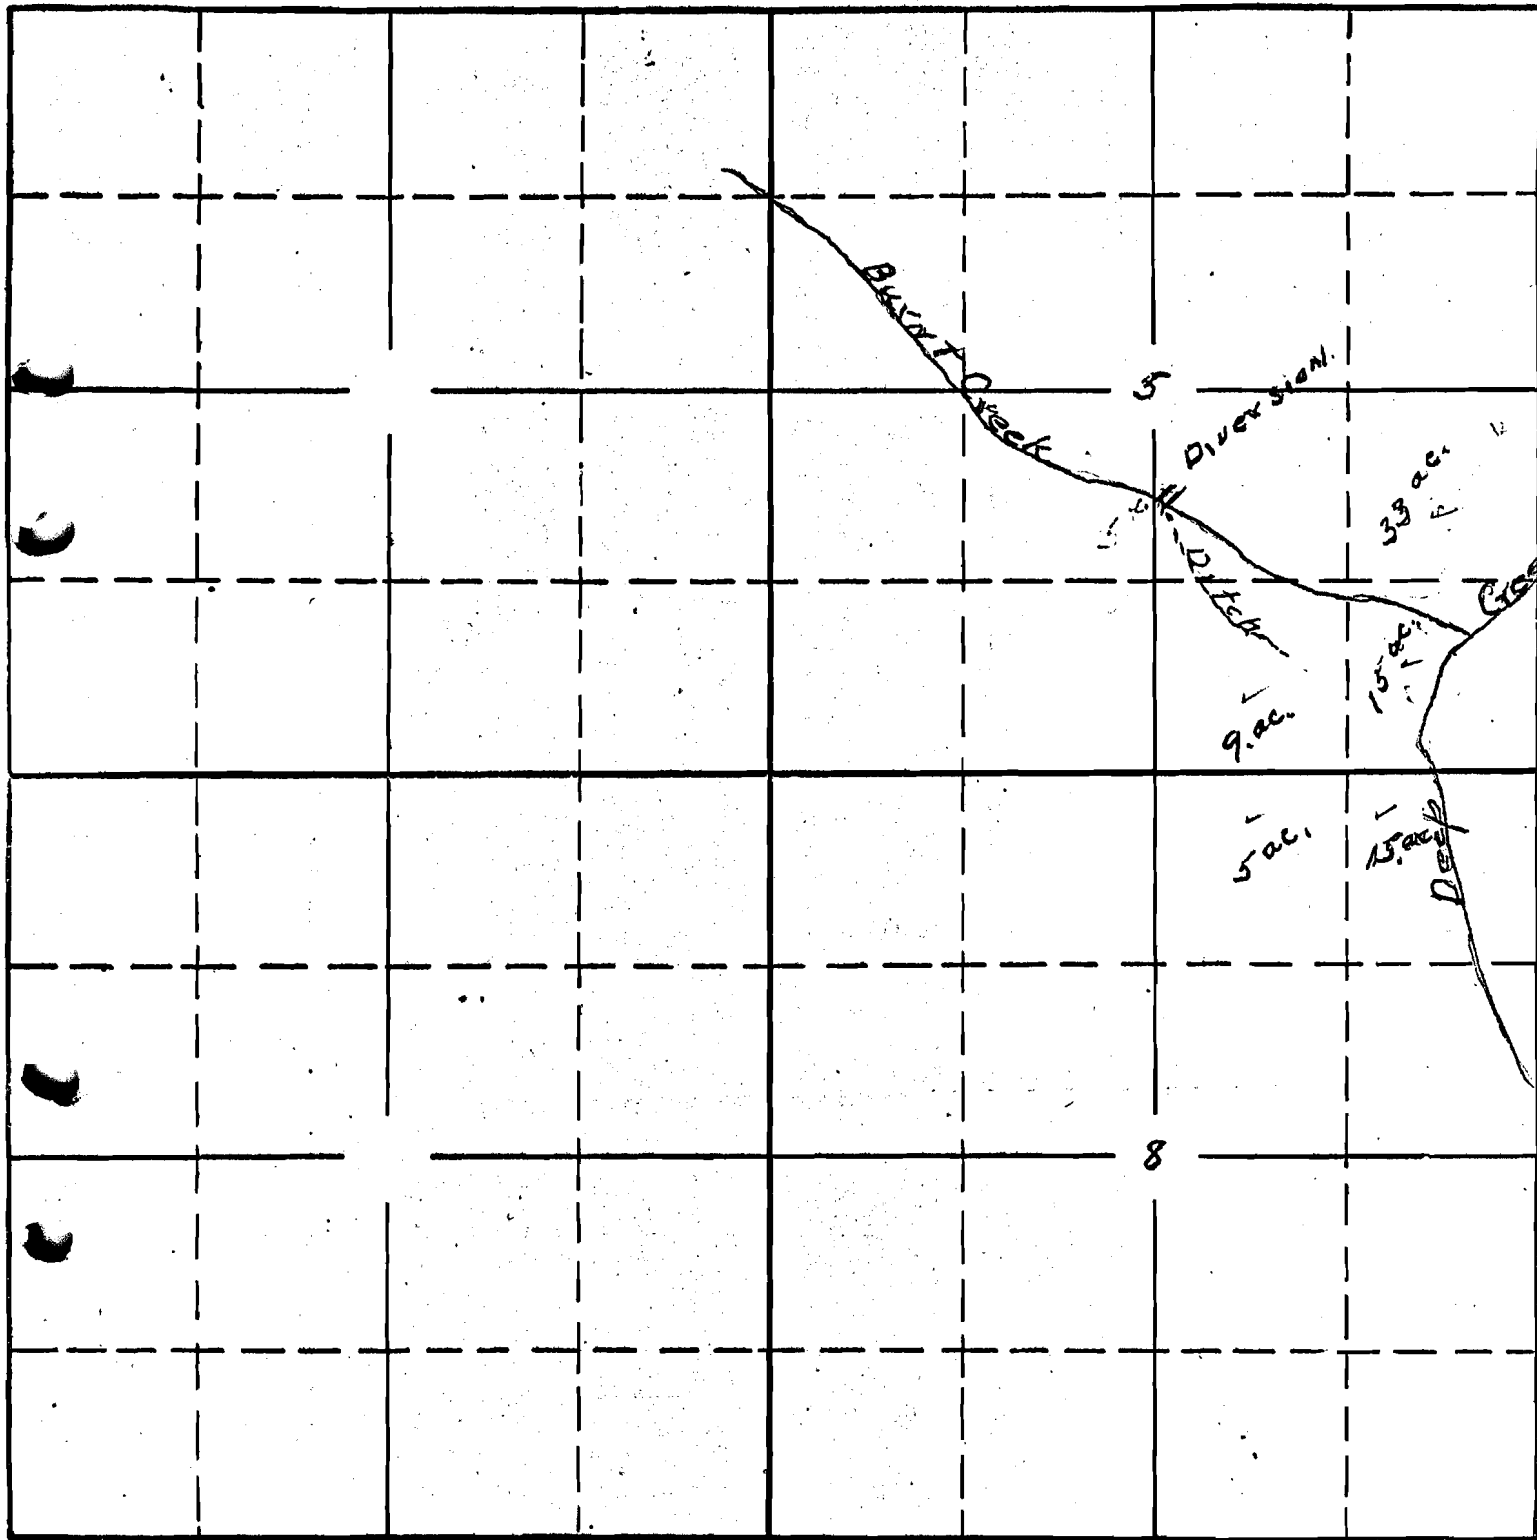

South

RECEIVED

OCT 28 1940

STATE ENGINEER
SALEM, OREGON

19068

OC
13-45

APPLICATION No. 19068

PERMIT No. 14664

40-22 ✓