


T. 2 S. R. 3 W. W. M.

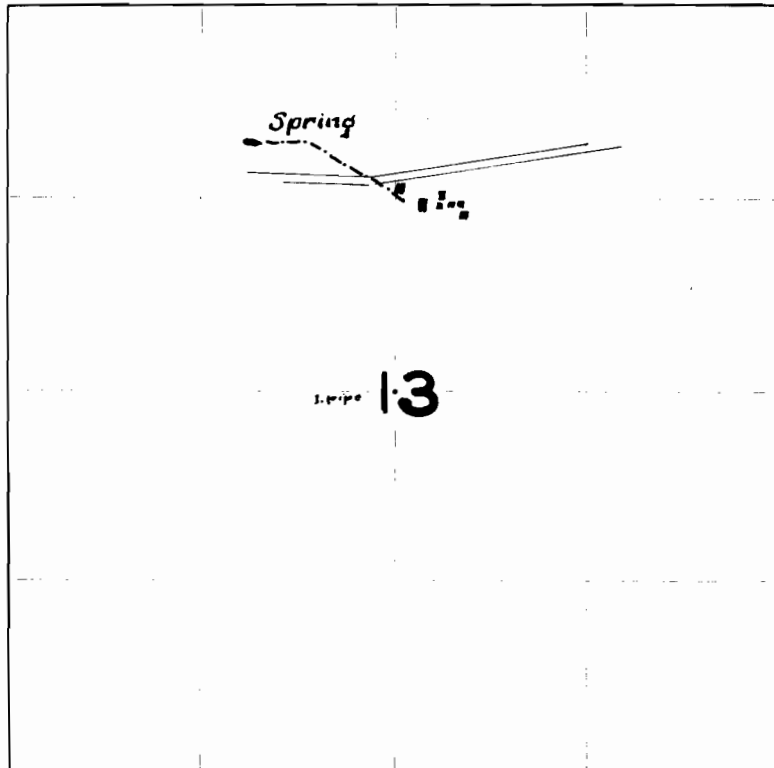

**FINAL PROOF SURVEY**  
UNDER

Application No. 25123.. Permit No. 19767.....  
IN NAME OF

JAMES & CLARA FREEMAN

Surveyed JULY 30 1951., by H.L. COFFMAN