


T.2S.R.2W.W.M.

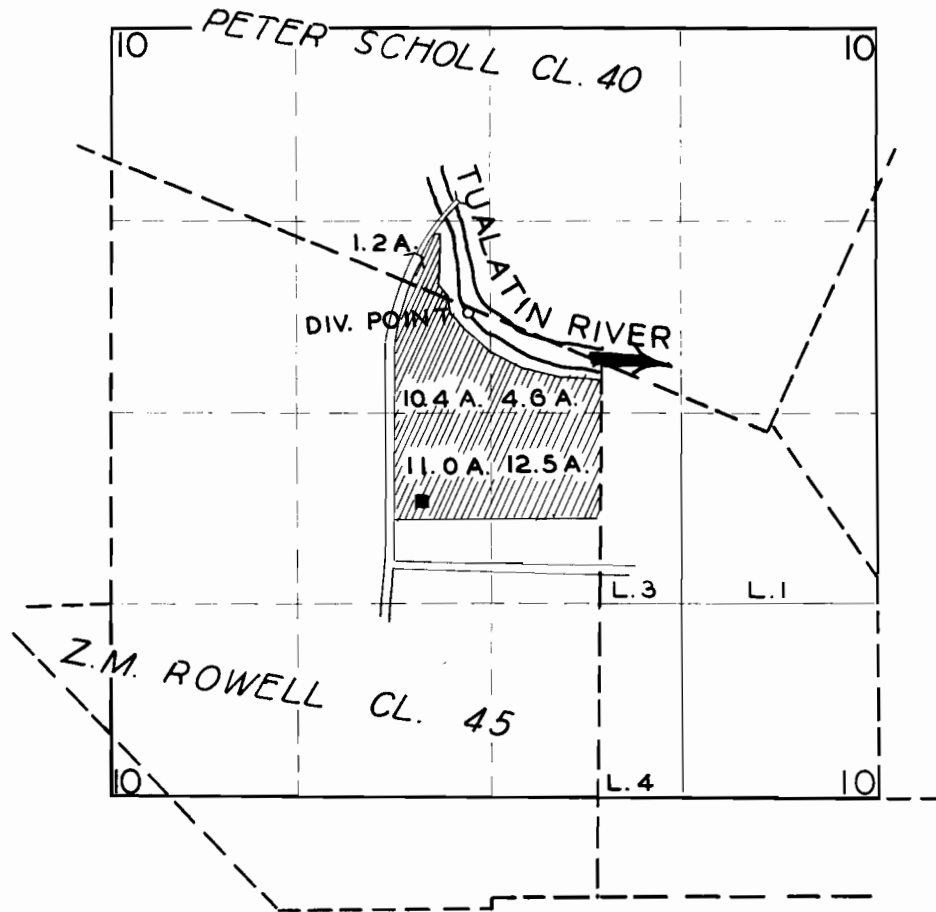

FINAL PROOF SURVEY UNDER

Application No. 25077 Permit No. 19740
IN NAME OF

MRS. INA SUTHERLAND

Surveyed MAY 31 1951, by H.L. COFFMAN