


T13S.R.1E.W.M.

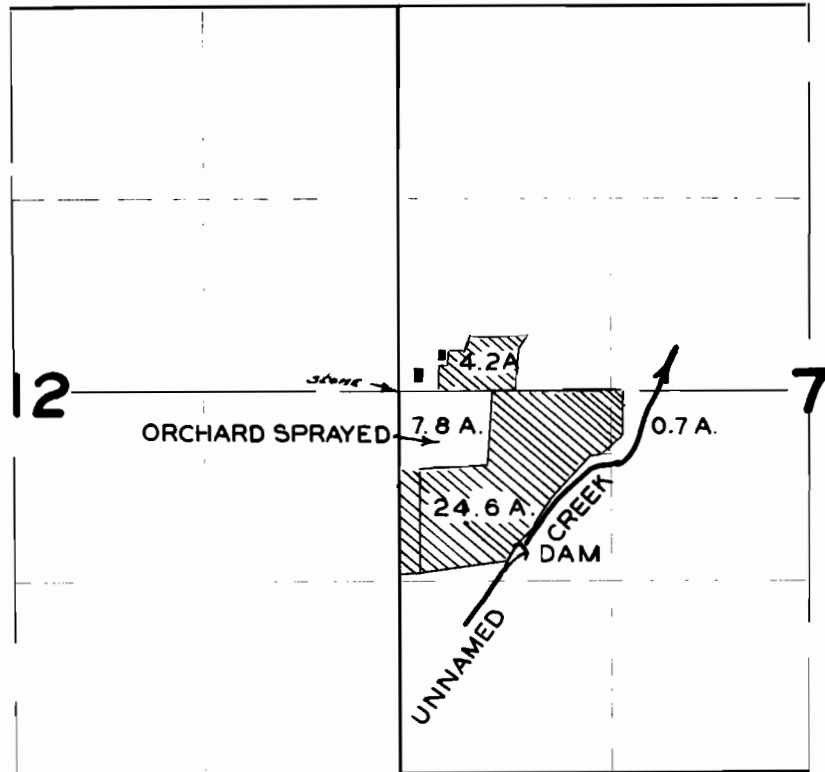

FINAL PROOF SURVEY
UNDER

Application No. 24997 Permit No. 19616
IN NAME OF

EMMEL & MARGUERITE REEVES

Surveyed APR. 18. 1951., by H.L. COFFMAN