


T.1N.R.4E.W.M.

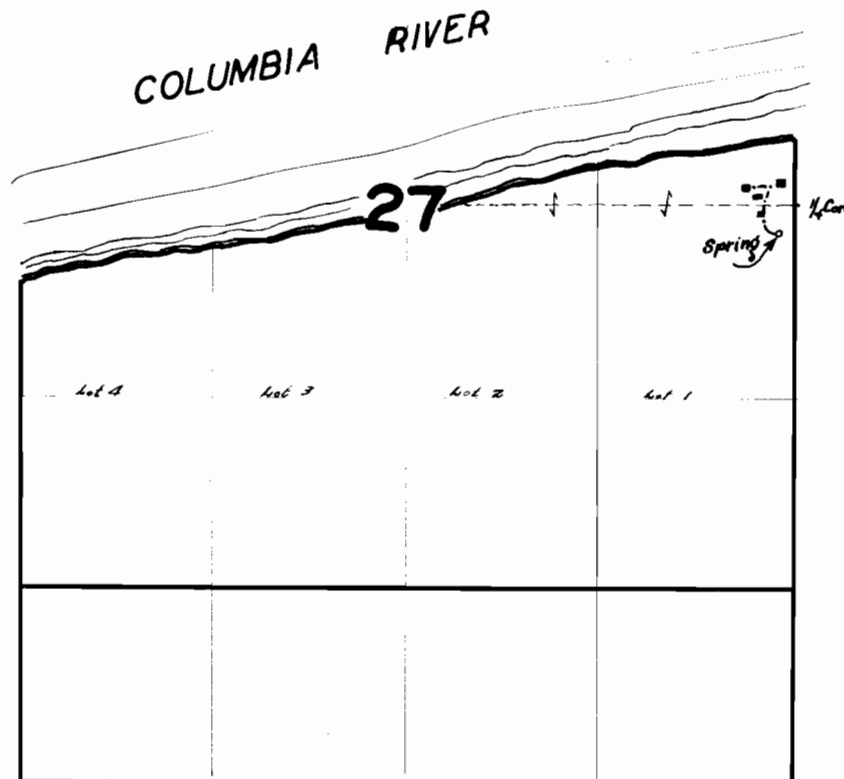

FINAL PROOF SURVEY

UNDER

Application No. 19808... Permit No. 15390...

IN NAME OF

H. PULLIAM, R. KINCAID, D. HANSEN, O. SWORDEN

Surveyed 10/18..... 1951., by H.L. COFFMAN..