


T.5S.R.3W.W.M.

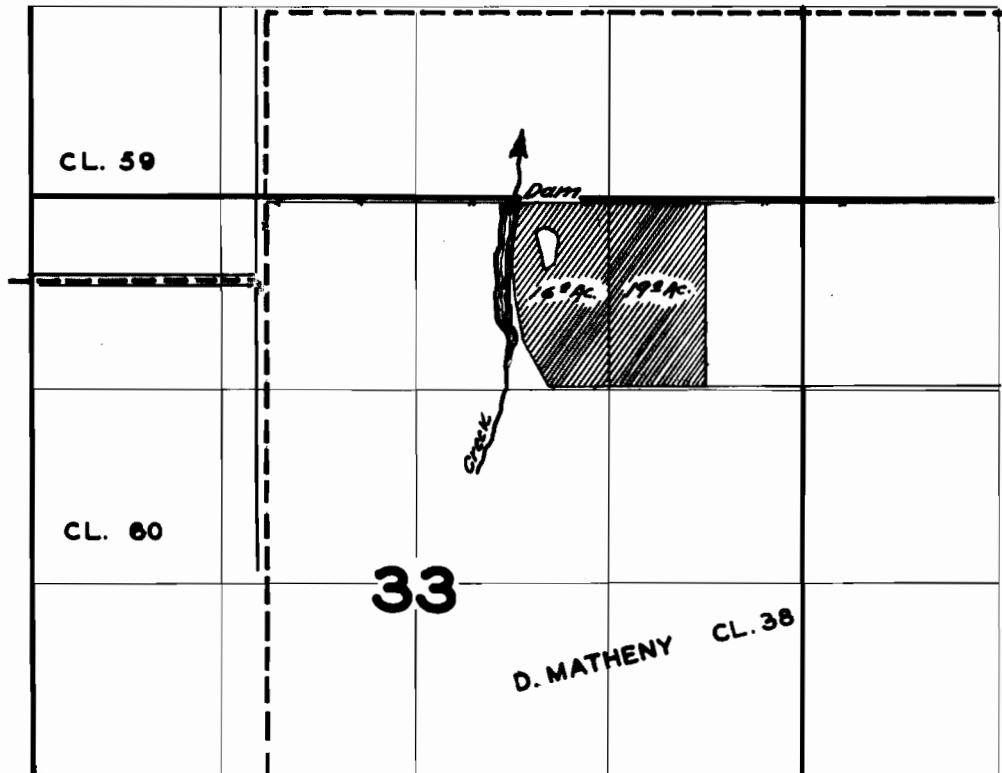

FINAL PROOF SURVEY UNDER

Application No. 21676... Permit No. 17090.
IN NAME OF

J. L. BEATY & L. K. GILCHRIST

Surveyed 9/25 1951, by H. L. COFFMAN