


T.5S.R.5W.W.M.

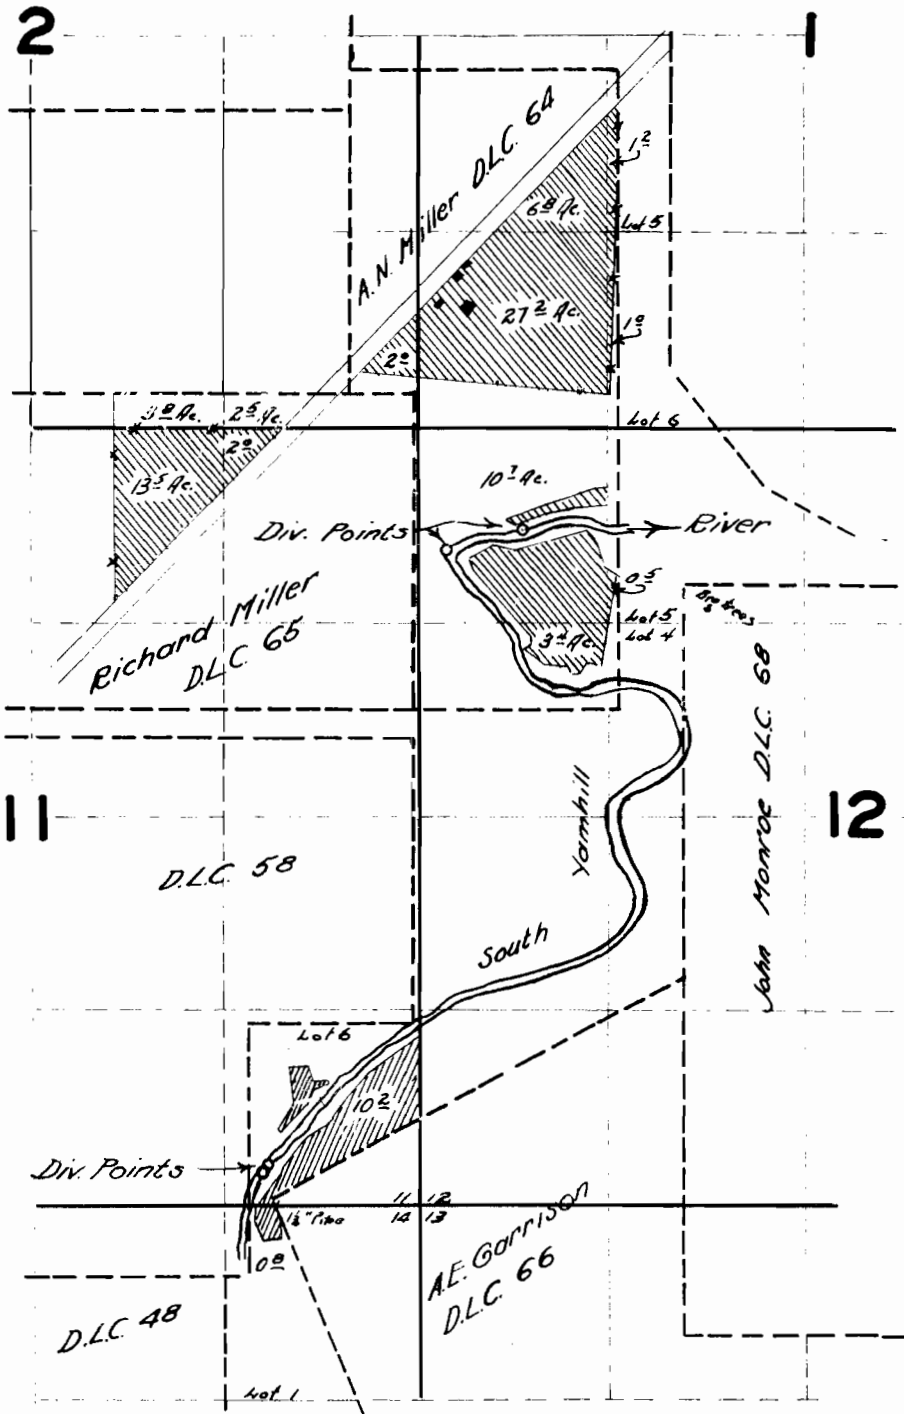

17643
23025

13340
18196

CHESTER L. MULKEY

9/17 1951 H.L. COFFMAN