


T.22S.R.32 $\frac{1}{2}$ E.W.M

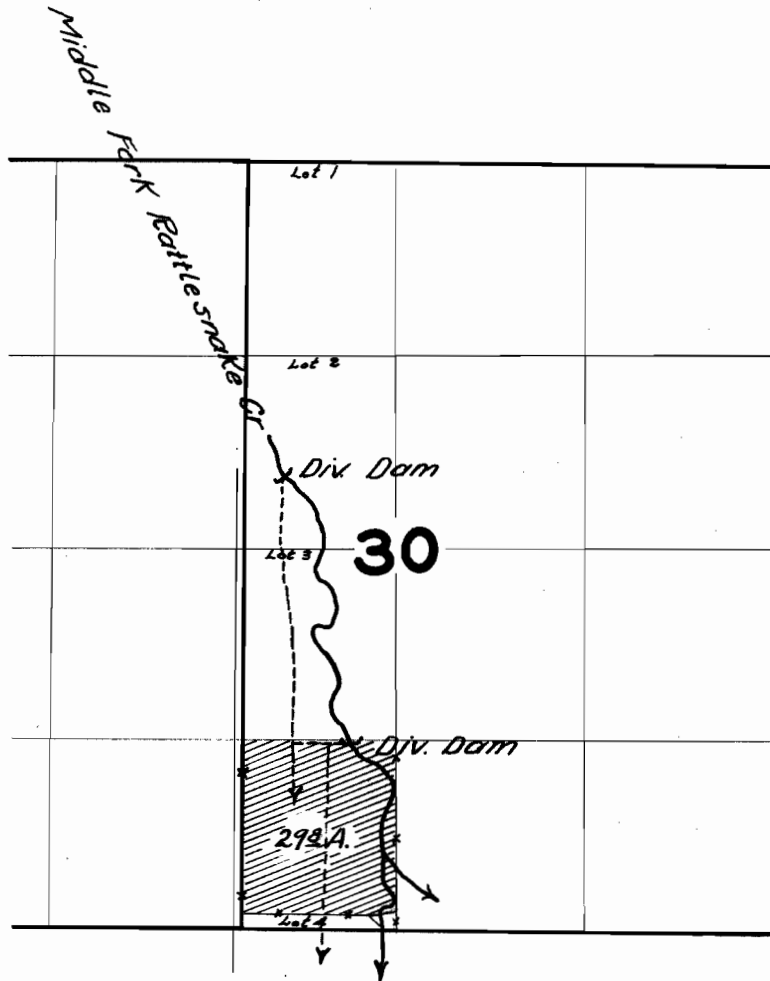

FINAL PROOF SURVEY
UNDER

Application No. 23488 Permit No. 18522
IN NAME OF

.....EARL WITHERS.....

Surveyed 7/20 1951, by H.L. COFFMAN.