


T25S.R.13W.W.M.

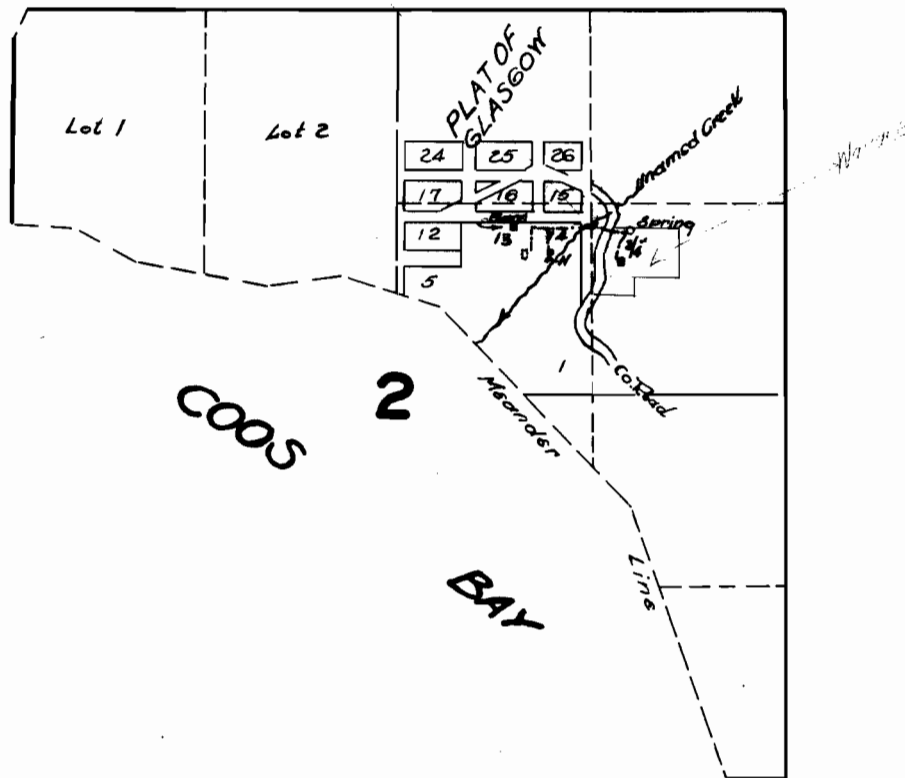

FINAL PROOF SURVEY

UNDER

21758

17116

Application No. ~~17116~~

Permit No. ~~21758~~

IN NAME OF

G.G. & BLANCHE BECKNER & H.SELFORS

Surveyed AUG. 20 1949, by H.L. COFFMAN