


T.3S. R.IW.W.M.

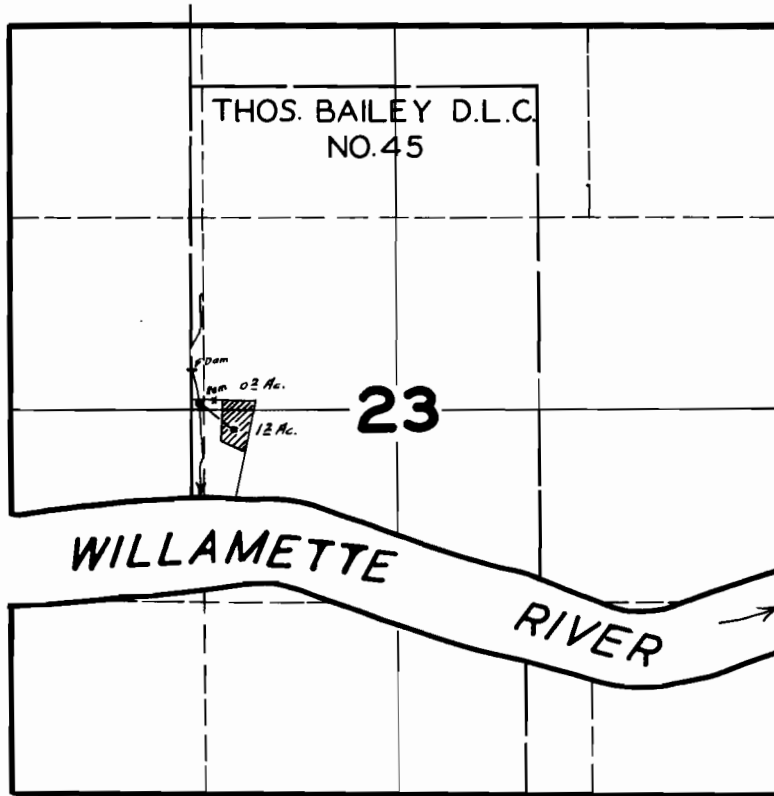

**FINAL PROOF SURVEY**  
UNDER

Application No. 18620 Permit No. 14257

IN NAME OF

MARGUERITE THOMASON & RUBY D. NUTTING

Surveyed JUNE 2, 1945, by *[Signature]*