


T.9S.R.40E.W.W

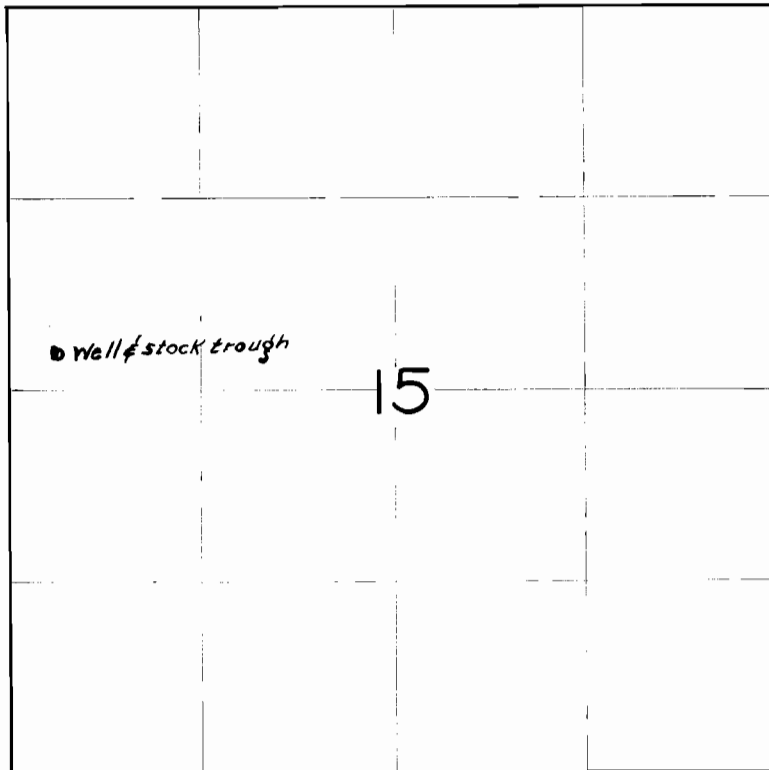

FINAL PROOF SURVEY

UNDER

Application No. U-128 Permit No. U-122

IN NAME OF

The BAKER PACKING COMPANY

Surveyed 9 / 10 1952, by H. C. COFFMAN