


# T. 39S.R. 20E.W.M.

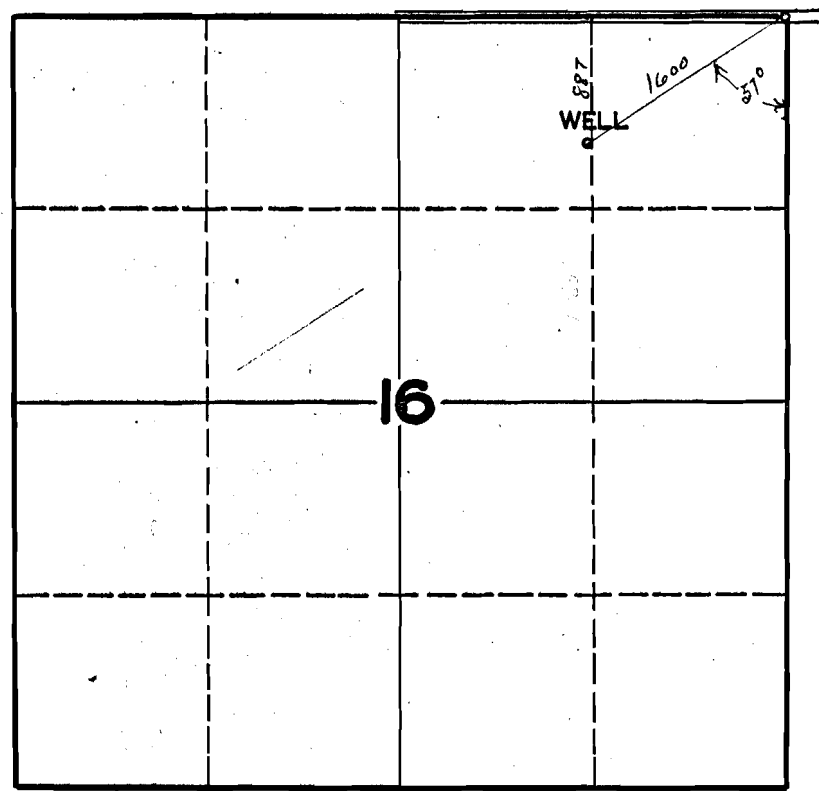

## FINAL PROOF SURVEY UNDER

Application No. U-130 Permit No. U-128

IN NAME OF

C. E. WILLIAMS

Surveyed MAY 22, 1946, by *[Signature]*