


T.18 S.R.46 E.W.M.

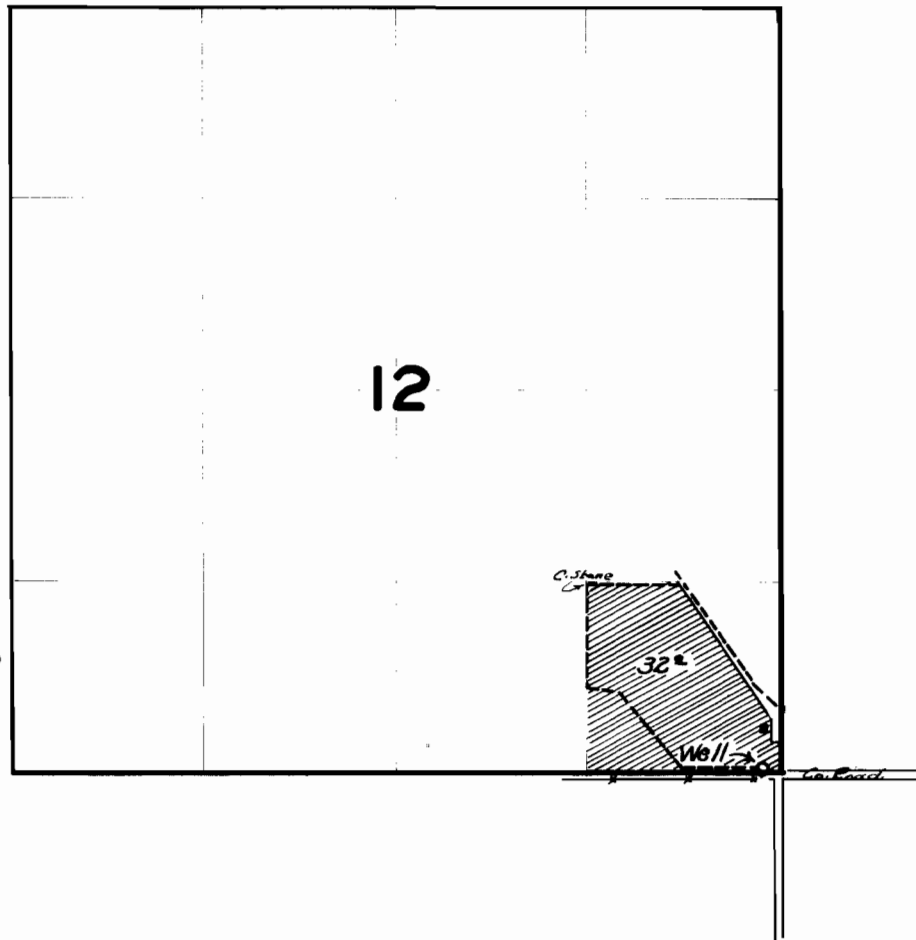

FINAL PROOF SURVEY
UNDER

Application No. U-263... Permit No. U-233
IN NAME OF

.....T.A. DOMAN.....

Surveyed 8/22 1951, by H.L. COFFMAN.