


T.2N.R.4W.W.M.

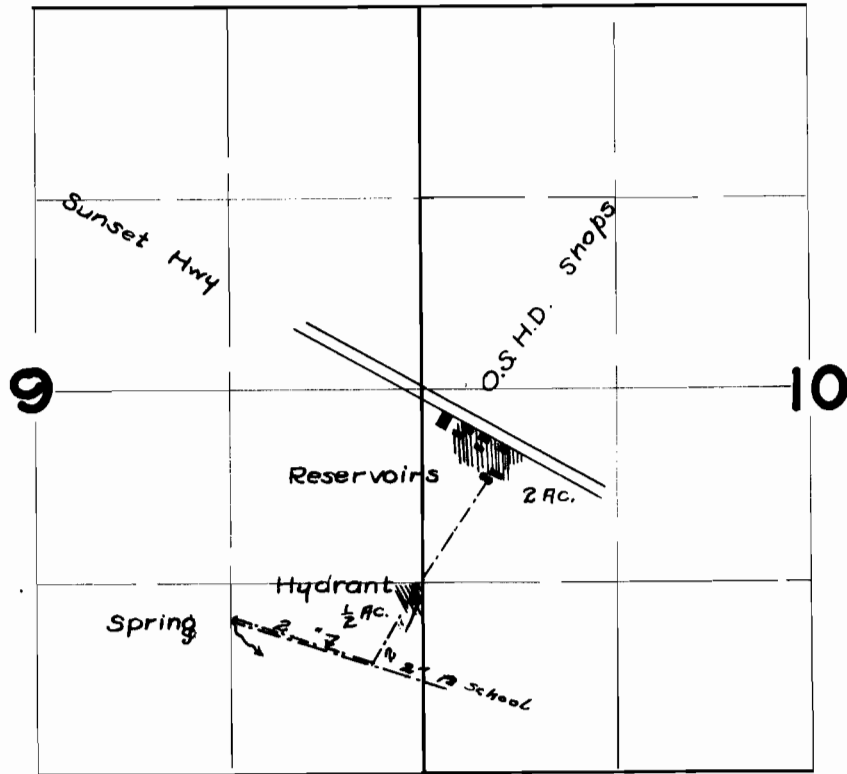

FINAL PROOF SURVEY

UNDER

Application No. 18097 Permit No. 13870

IN NAME OF

REX E. ROSE & ALLENA ROSE

Surveyed 7 / 10 1952, by H. L. COFFMAN