


T.4 S.R.I.W.W.M.

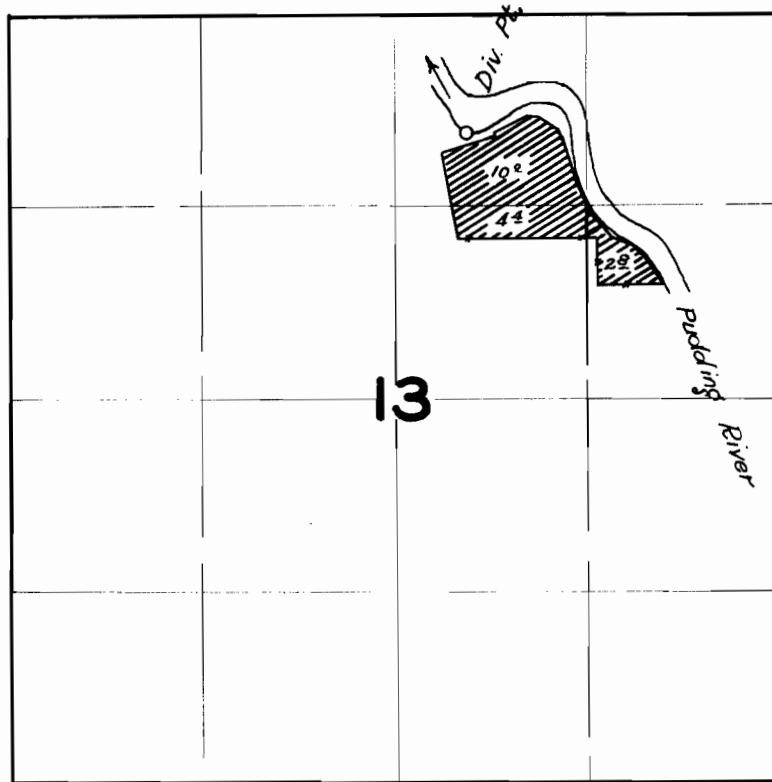

FINAL PROOF SURVEY UNDER

Application No. 16932 Permit No. 12712
IN NAME OF

John P. and Rena B. McCrone

Surveyed 2/26 1952, by H.L. COFFMAN