


T.2 N.R.4 W.W.M.

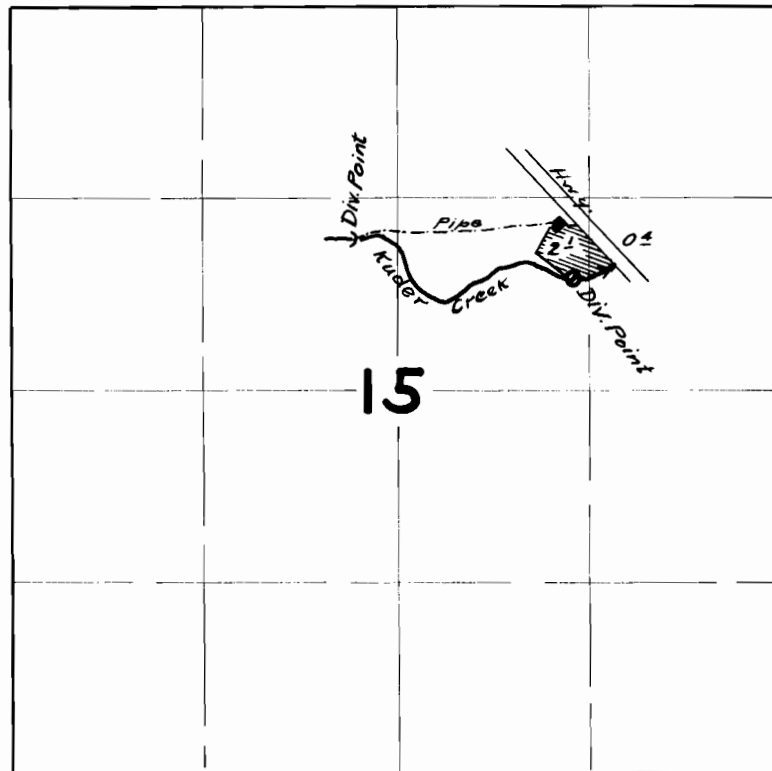

FINAL PROOF SURVEY
UNDER

Application No. 17650 Permit No. 13345
IN NAME OF

Mrs. VESTA A. FREDERICK

Surveyed 6 / 27 / 1952 by L. L. CORLEMAN