


T. I. S. R. 2 W. W. M.

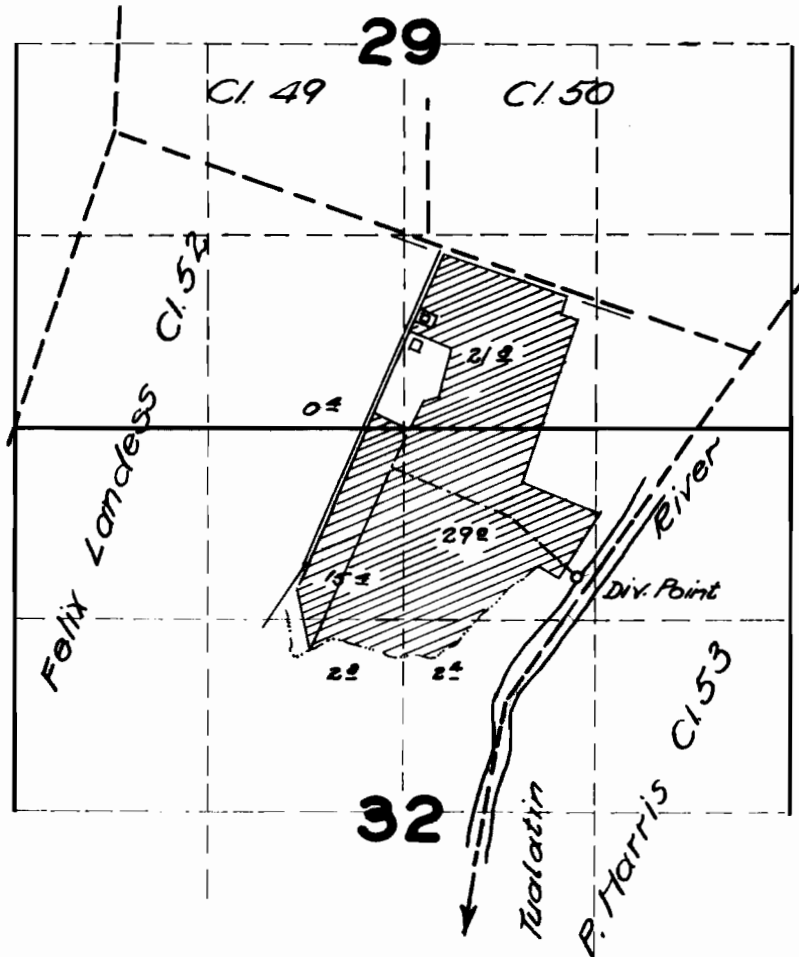

FINAL PROOF SURVEY

UNDER

Application No. 18109 Permit No. 13763

IN NAME OF

W. T. PUTNAM & SONS

Surveyed May 7, 1952, by H. L. COFFMAN