


T.3&4S.R.2W.W.M.

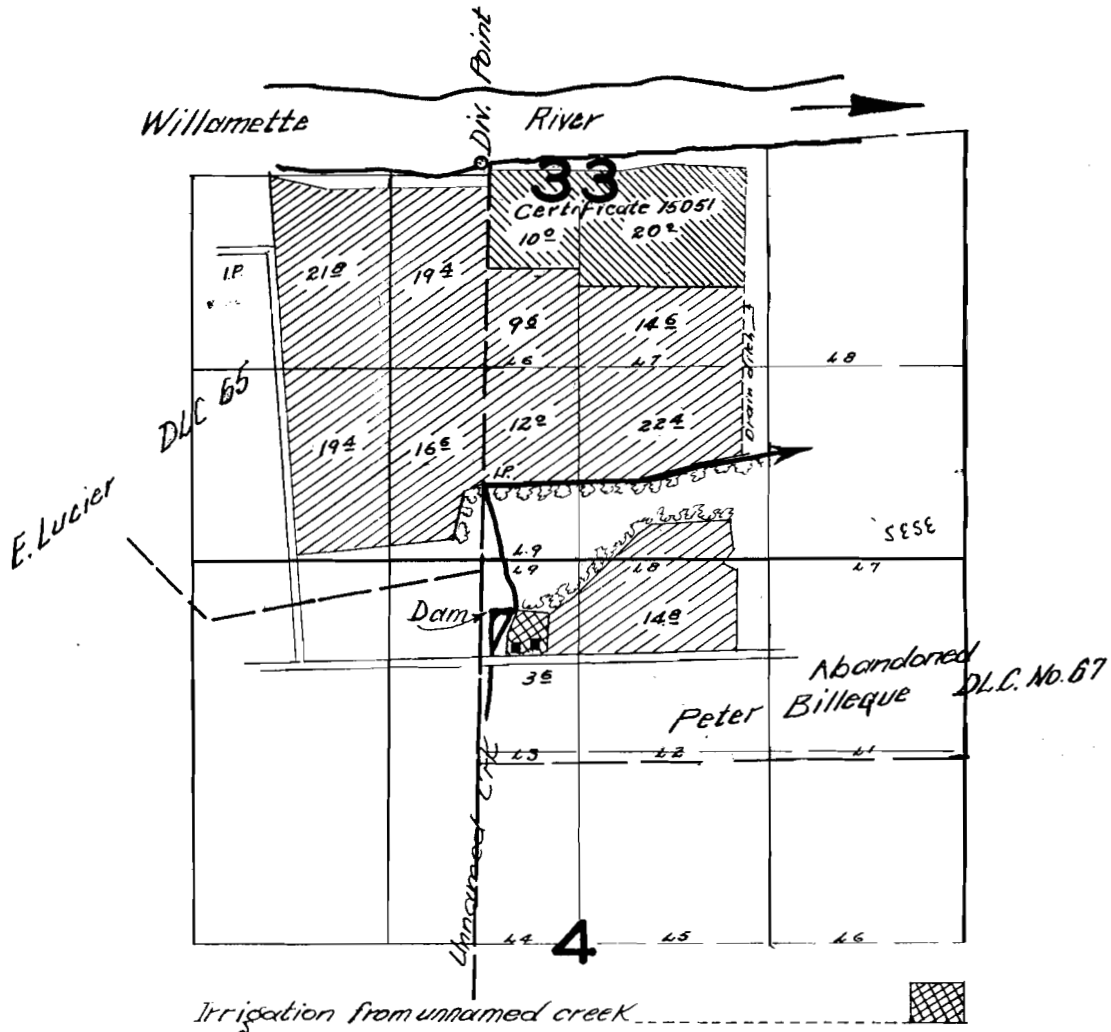

FINAL PROOF SURVEY

Appl. No. 18115 UNDER Permit No. 13768
 Appl. No. 19150 - Permit No. 11750
 Application No. 20279 Permit No. 15227

IN NAME OF

WALTER J. GEARTH

Surveyed 2/22 1952, by J. L. SOUTMAN