


T.2N.R.5W.M.

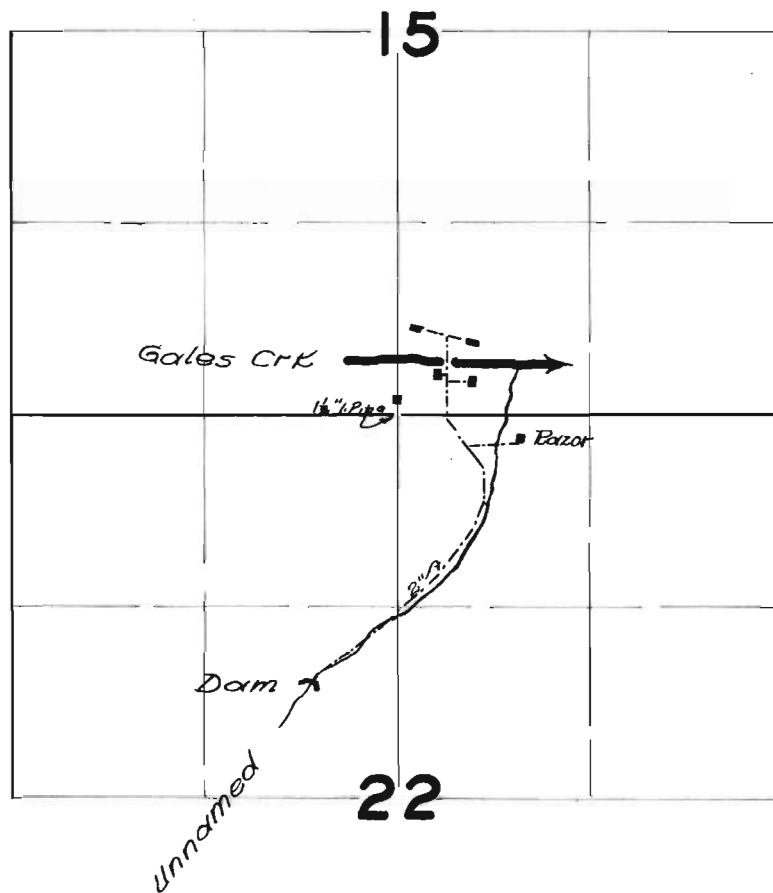

FINAL PROOF SURVEY

UNDER

Application No. 19667 Permit No. 15248

IN NAME OF

LOUISE JONES SEARS

Surveyed 7 / 16 1952, by H. L. COFFMAN