


T.3&4S.R.2W.W.M.

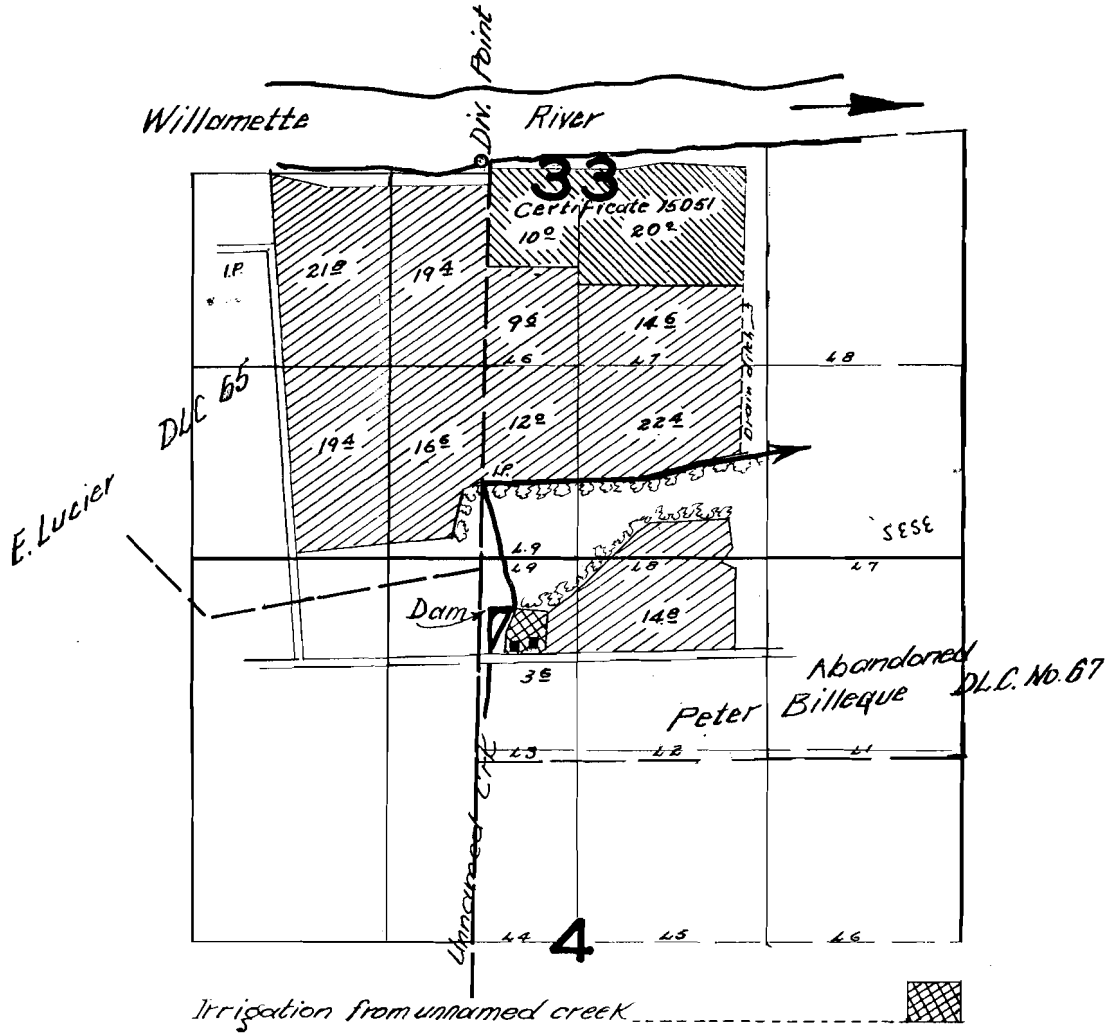

FINAL PROOF SURVEY

Appl. No. 18115 UNDER Permit No. 13768

Appl. No. 19150 - Permit No. 11750

Application No. 20272 Permit No. 15227

IN NAME OF

WALTER J. GEARTH

Surveyed 9 / 22 1952, by H. L. SWANMAN