T. 2 N. R 2 & 3 W. W. M.

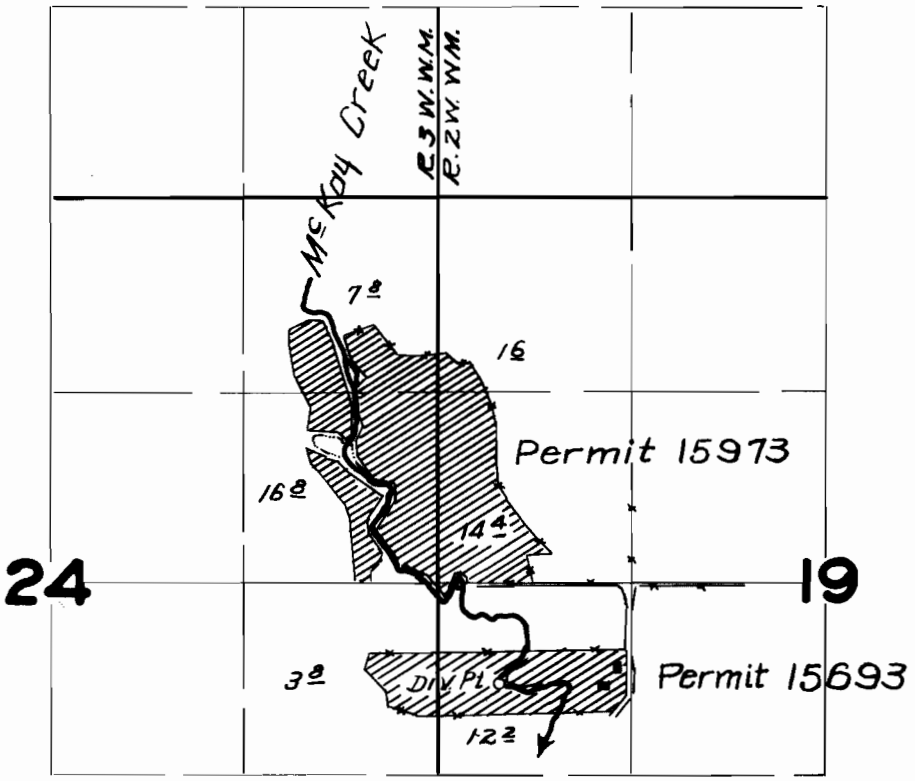

FINAL PROOF SURVEY

UNDER

Application No. 20456 / 20130 Permit No. 15973 / 15693

IN NAME OF

F. R. Henning

J. LeRoy Mills

Surveyed 6 / 18 1952, by H. L. COFFMAN

1952 D