


T. I. S. R. 3 W. W. M.

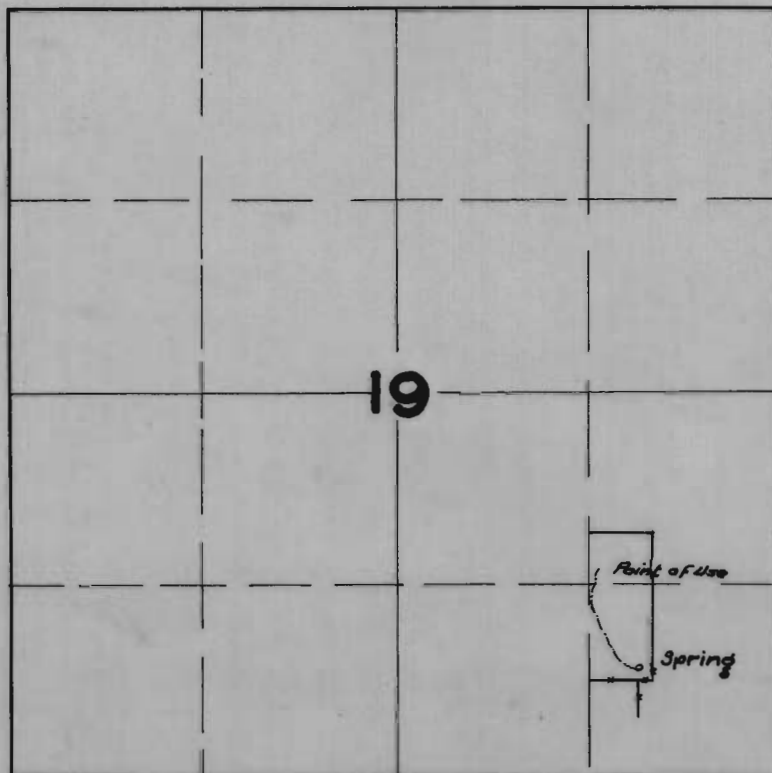

FINAL PROOF SURVEY
UNDER

Application No. 20742 Permit No. 16234
IN NAME OF

FRANCIS SANDSTROM

Surveyed 4 / 16 1952, by H. L. GOFFMAN