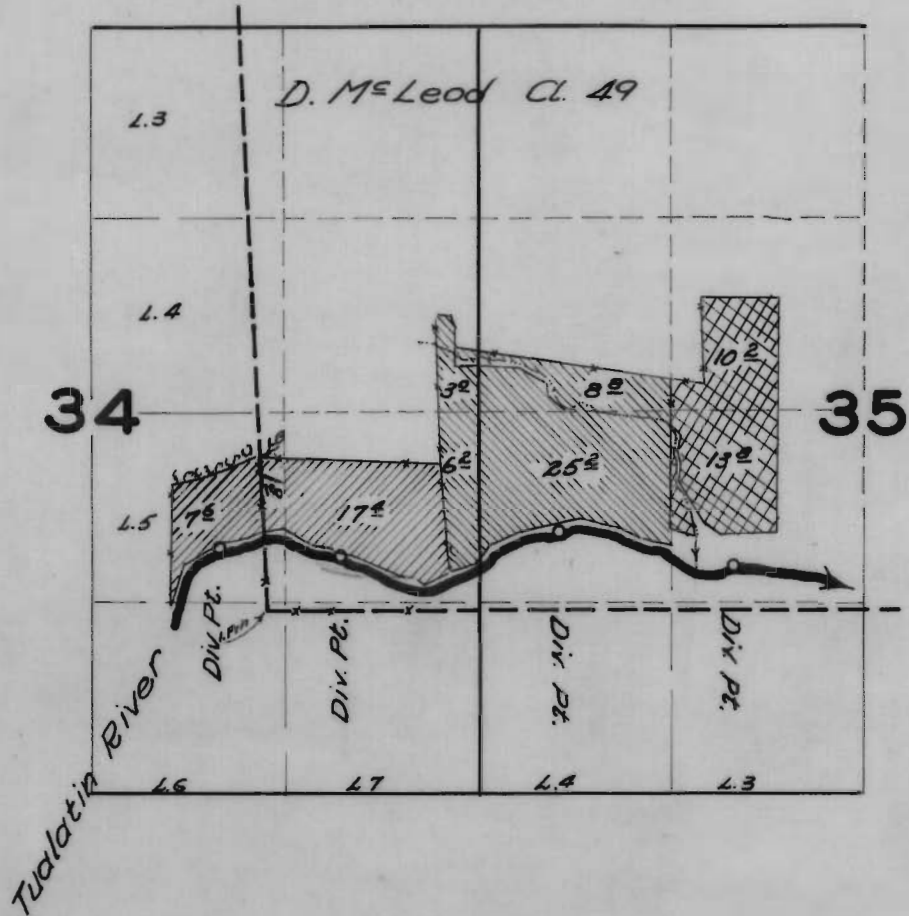

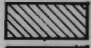



T. IS. R. 4 W.W.M.



FINAL PROOF SURVEY

UNDER

GEO. H. BEELR	APP. 21647	PER. 17005	
P. E. GARDNER	APP. 22301	PER. 17585	
G. M. WOOD	APP. 20808	PER. 16284	

APR. 4 1952

H. L. COFFMAN