


T.6S.R.3W.W.M.

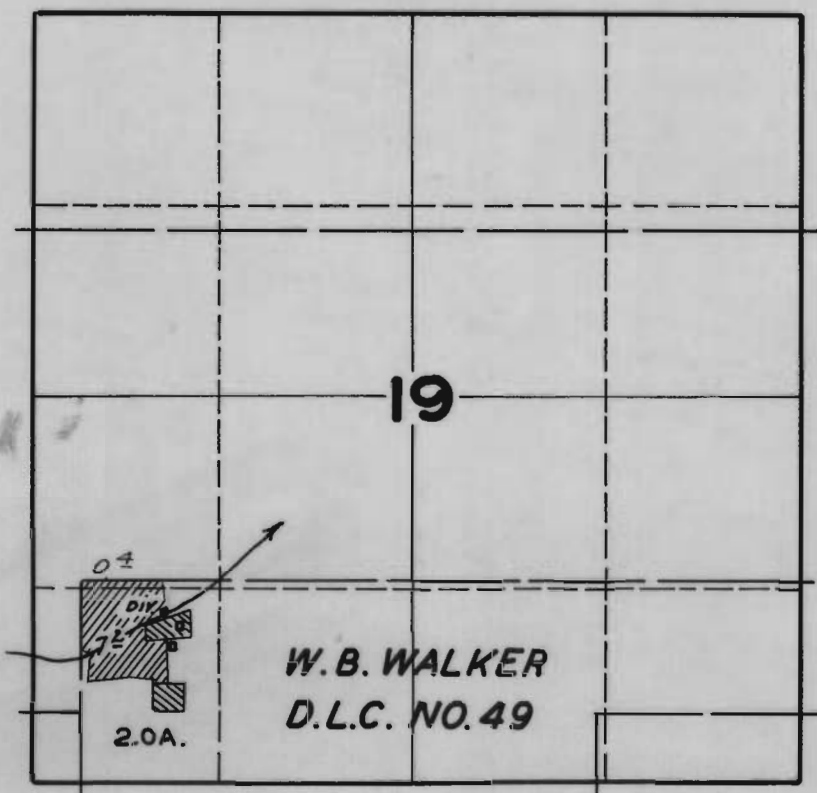

FINAL PROOF SURVEY

UNDER

Application No. 20830 Permit No. 16327

IN NAME OF

T. L. HICKS

Surveyed MAR. 30 1949, by JAS. E. BUNNELL