


T.2N.R.4W.W.M.

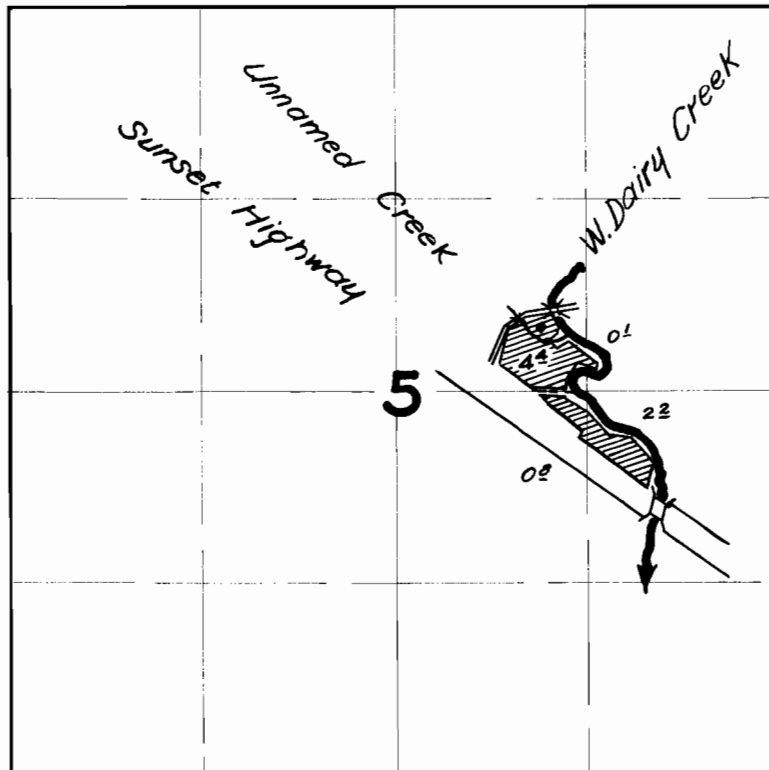

FINAL PROOF SURVEY

UNDER

Application No. 21368 Permit No. 16789

IN NAME OF

RUSSELL E. & RUTH E. O'CONNOR

Surveyed 7 / 7 1952, by H. L. COFFMAN