


T.9S.,R.3E.,W.M.

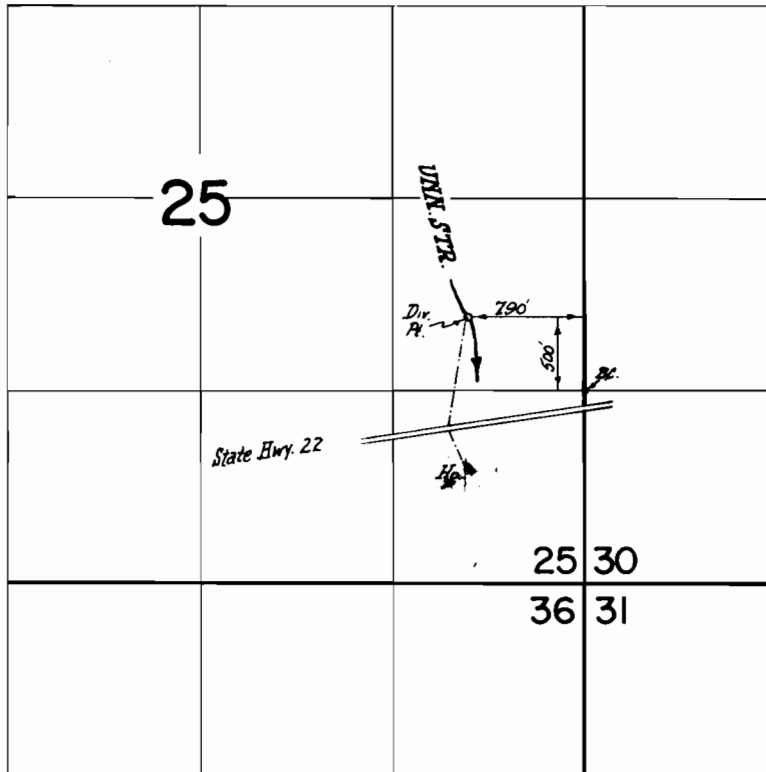

FINAL PROOF SURVEY
UNDER


Application No. 21434 Permit No. 16815
IN NAME OF

Albert L. Harris

Surveyed Aug. 3, 1977, by B.R. Sund

T.9S.R.3E.W.W.M.

VOID

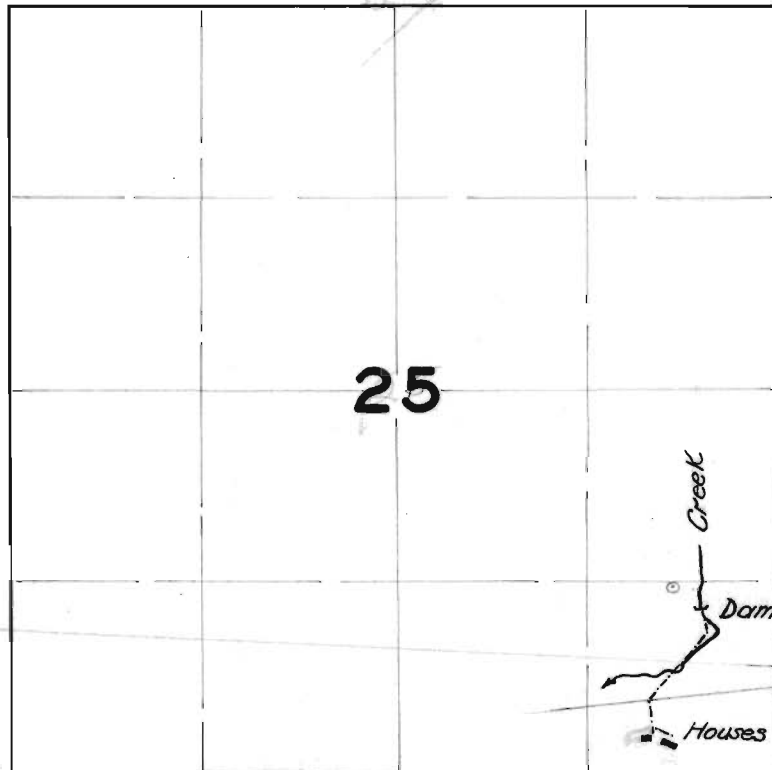

FINAL PROOF SURVEY

UNDER

Application No. 21434 Permit No. 16815

IN NAME OF

CARL H. SMITH

Surveyed 9 / 25 1952 by H. L. GOFFMAN