


# T.1S.R.2W.W.M.

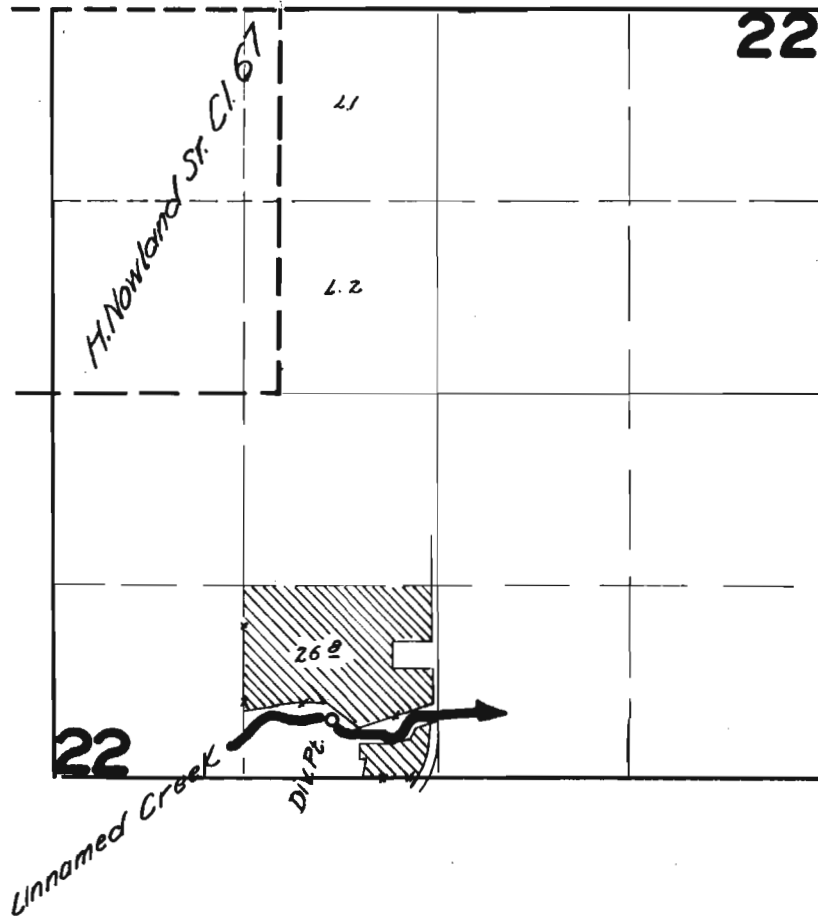

## FINAL PROOF SURVEY

UNDER

Application No. 21485 Permit No. 16852

IN NAME OF

JAKE SCHLESSER

Surveyed May 15, 1952, by H. L. GOFFMAN