


# TIN. R. 3 W. W.M.

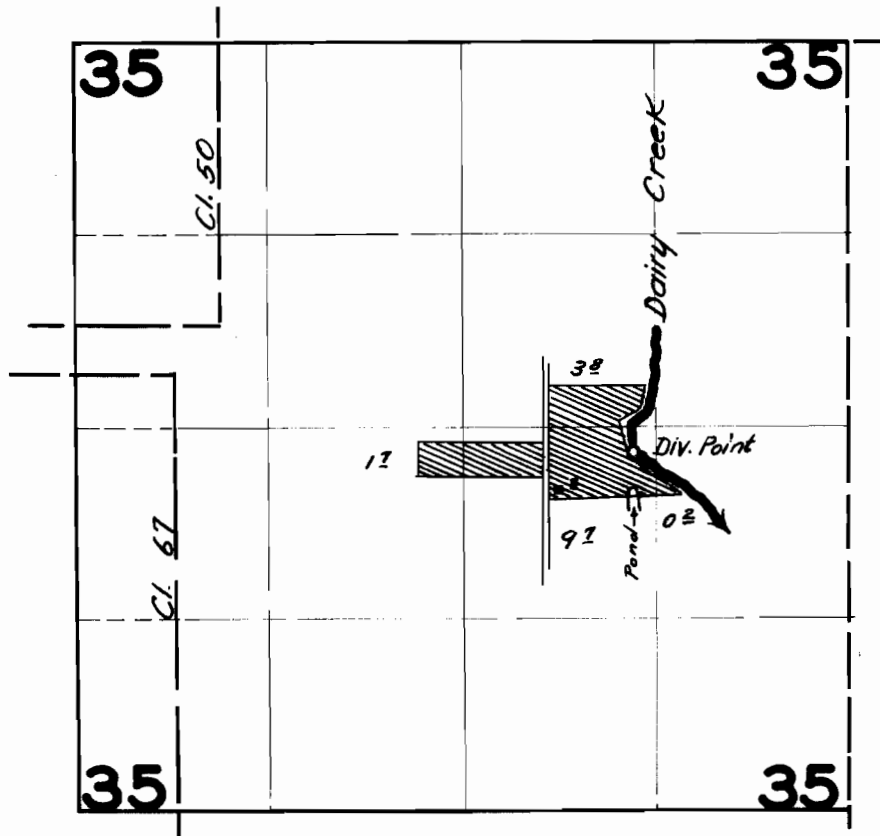

## FINAL PROOF SURVEY

UNDER

Application No. 21561 Permit No. 16905

IN NAME OF

A. A. HODGES AND ELEANOR HODGES

Surveyed June 2, 1952, by H. L. COFFMAN