


T.2N.R.5W.W.M.

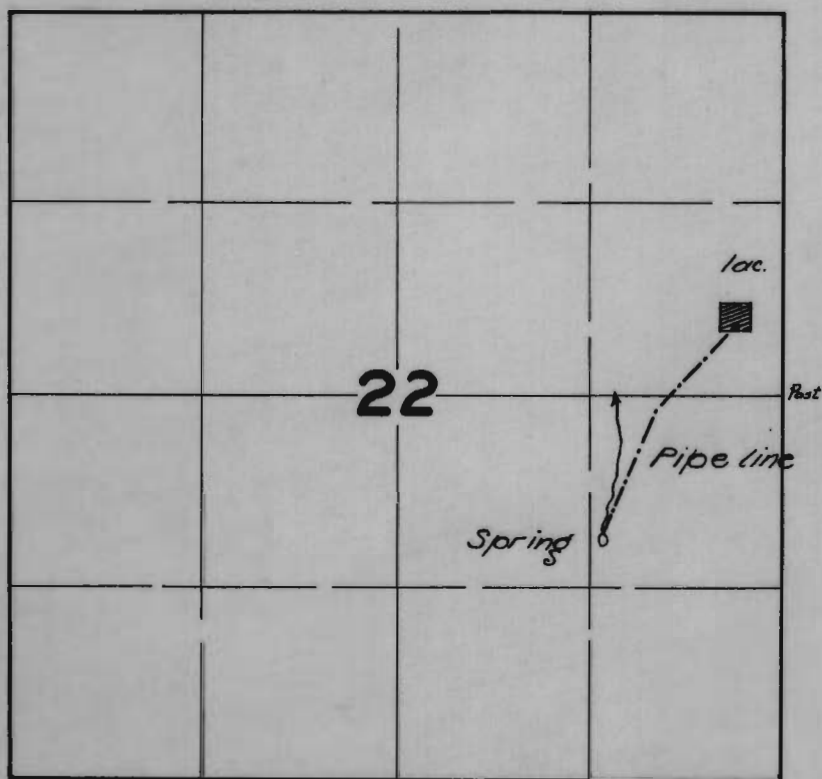

FINAL PROOF SURVEY

UNDER

Application No. 21699 Permit No. 17040

IN NAME OF

ALVIN HESS

Surveyed 7 / 16 1952, by H. L. COFFMAN