


T.I.S.R.4W.W.M.

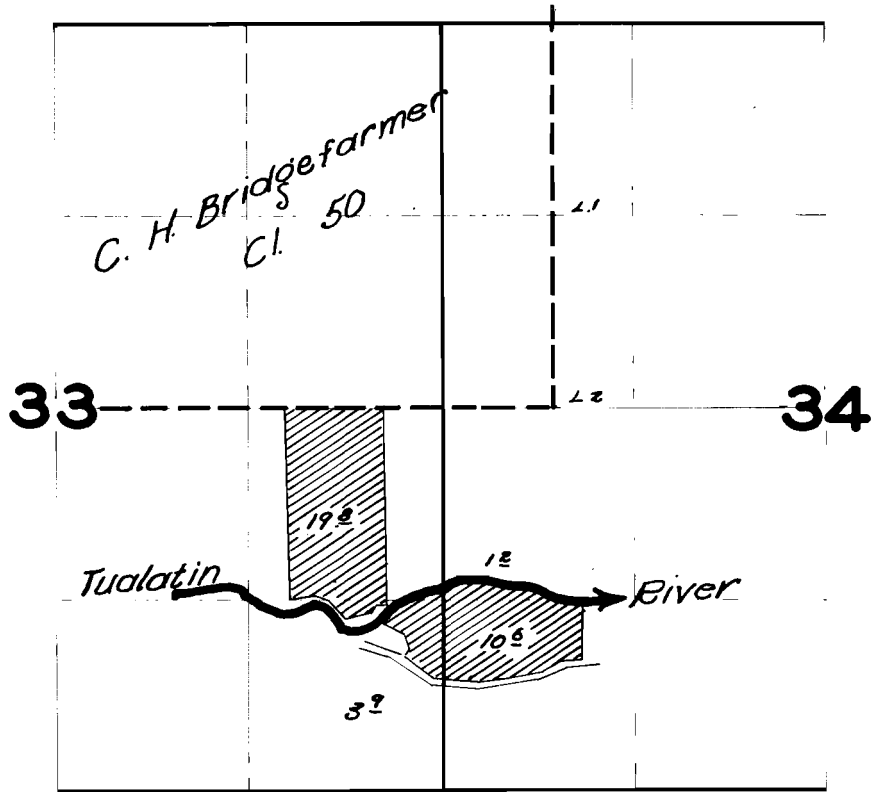

FINAL PROOF SURVEY
UNDER

Application No. 21593 Permit No. 16967
IN NAME OF

CARLTON ROSE NURSURIES, INC.

Surveyed Apr. 10, 1952, by H. L. Coffman