


T2S.R.2W.W.M.

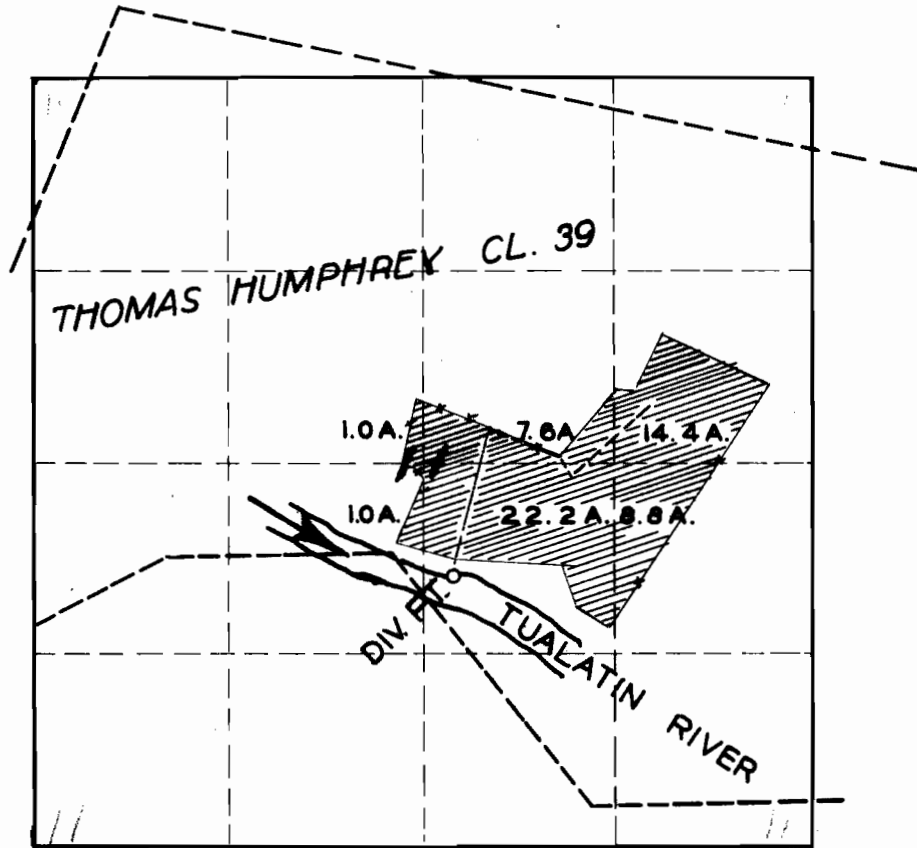

FINAL PROOF SURVEY UNDER

Application No. 21606... Permit No. 16975...
IN NAME OF

.....
WALDO FLINT
.....

Surveyed JUNE 4, 1951, by H.L. COFFMAN