


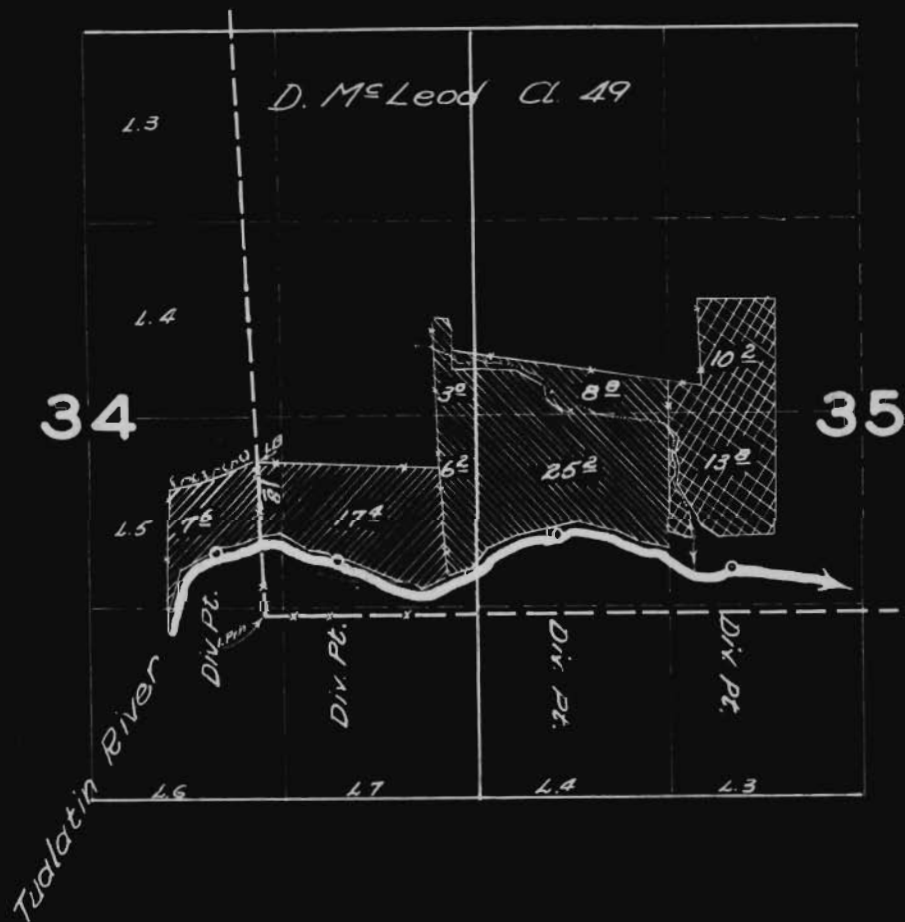


T. IS. R. 4 W.W.M.



FINAL PROOF SURVEY

UNDEF

| | | | |
|---------------|------------|------------|---|
| GEO. H. BEELR | APP. 21647 | PER. 17005 |  |
| P. E. GARDNER | APP. 22301 | PER. 17585 |  |
| G. M. WOOD | APP. 20808 | PER. 16284 |  |

APR. 4 1952

H. L. COFFMAN