


T. 1 S. R. 5 W. W. M.

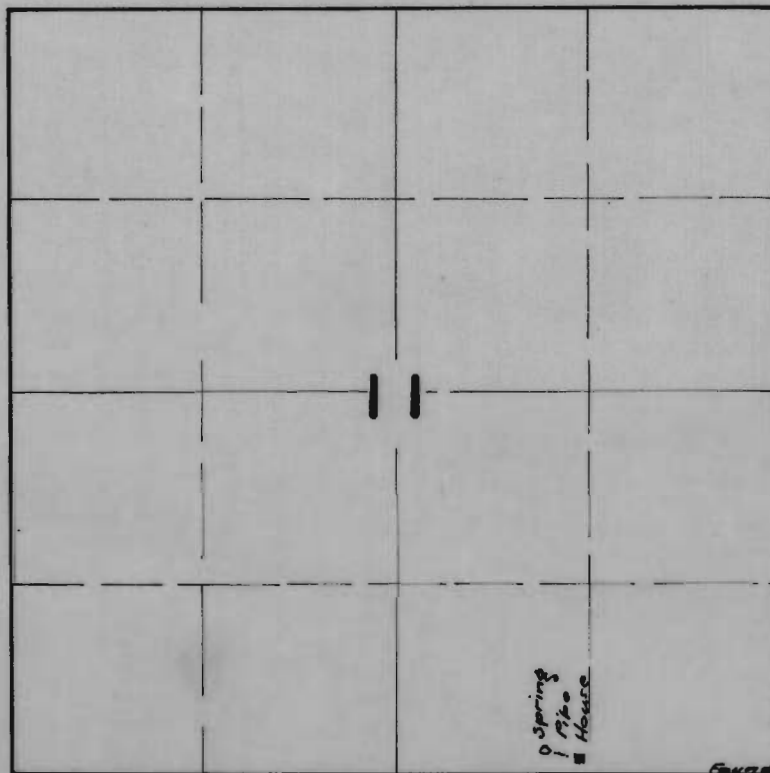

FINAL PROOF SURVEY
UNDER

Application No. 21742 Permit No. 17060
IN NAME OF

WM. M. LaMORE AND DAPHNE LaMORE

Surveyed 4 / 14 1952, by H. L. COFFMAN