


T. 9S. R. 40 E.W. M.

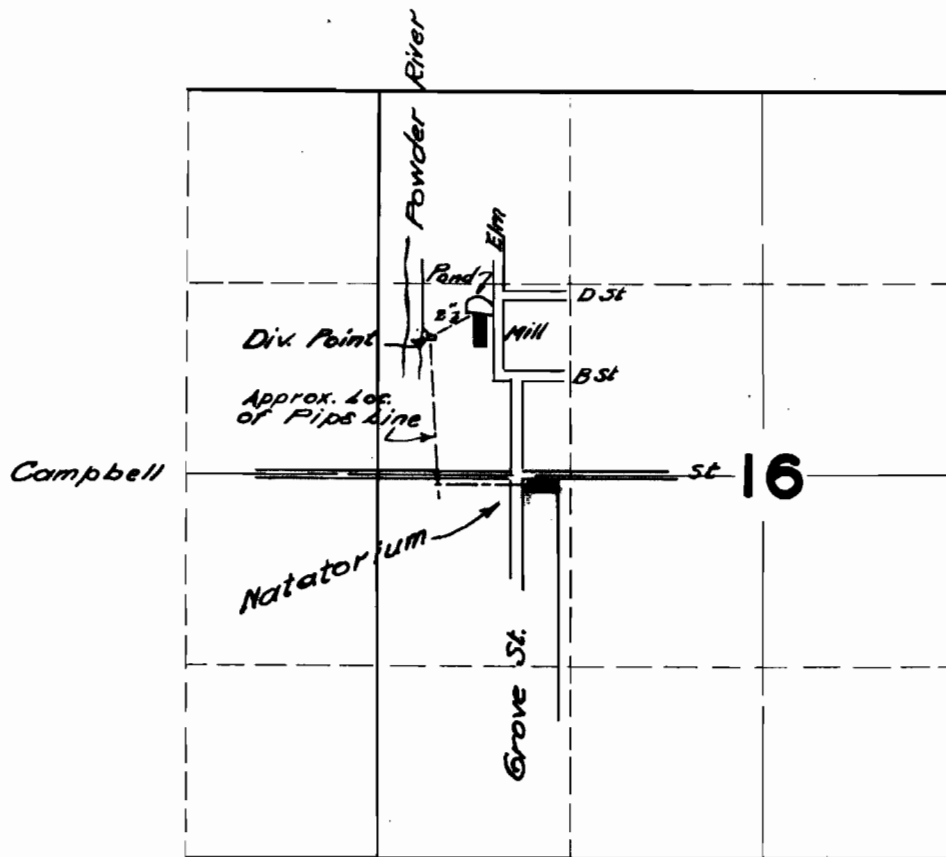

FINAL PROOF SURVEY

UNDER

Application No. 21903.. Permit No. 17243..

IN NAME OF

JOHNE, NICKE, & GUSE PAPANIKOLS..

Surveyed NOV. 25. 1949., by H.L. COFFMAN