T. 1 S. R. 4 W. W. M.

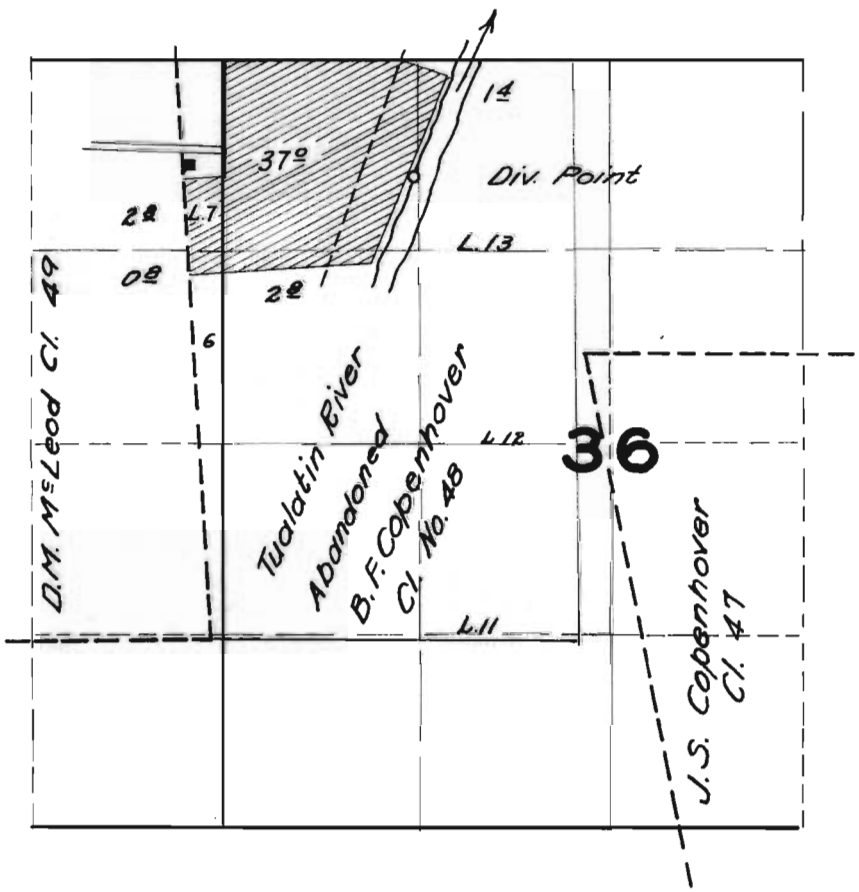

FINAL PROOF SURVEY

UNDER

Application No. 22538 Permit No. 17752

IN NAME OF

A. J. BERRY

Surveyed APR. 2 1950, by H. L. COFFMAN

1952 A