


TIN. 2 W.W.M.

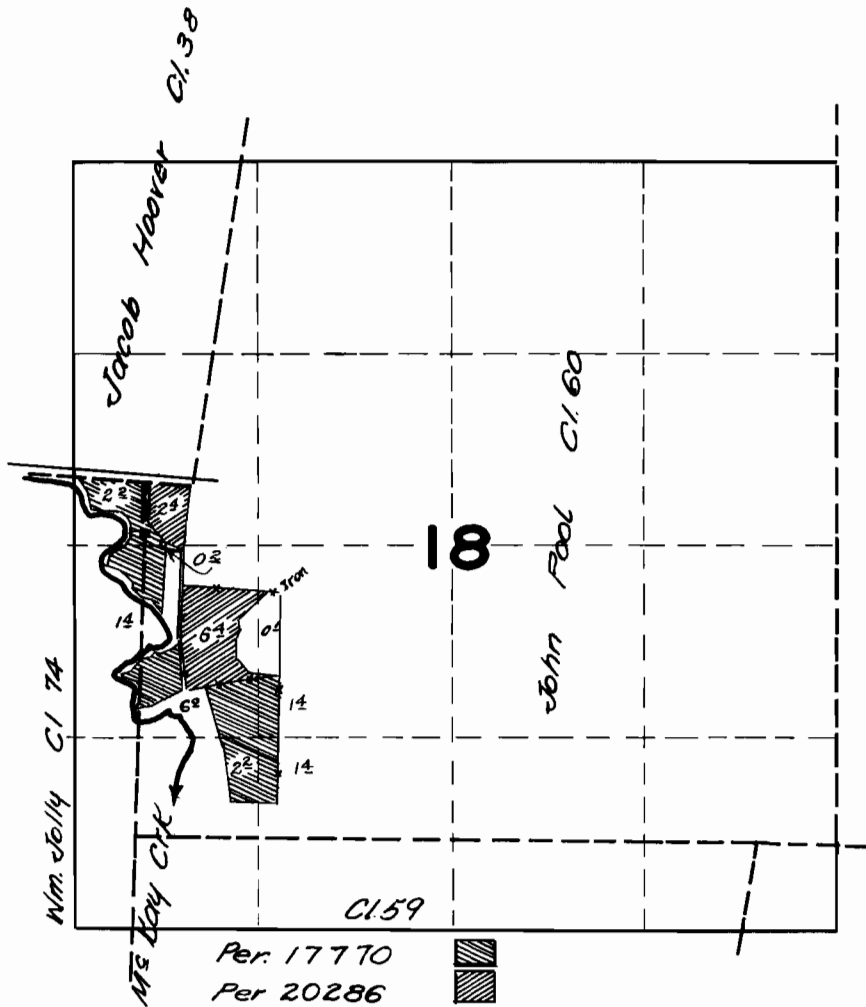

FINAL PROOF SURVEY

UNDER

22501

17770

Application No. 25819 Permit No. 20286

IN NAME OF

WILLIAM T. AND MARIE E. ROSS

Surveyed 6 / 13 1952, by A. L. COFFMAN