


T.2N.R.2W.W.M.

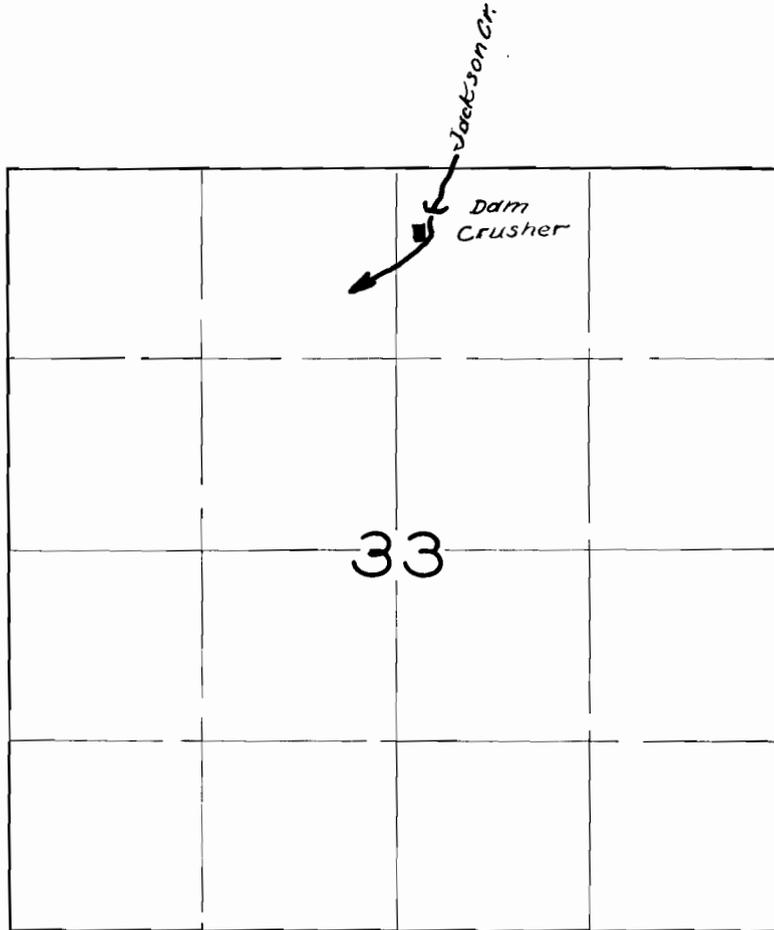

FINAL PROOF SURVEY

UNDER

Application No. 22640 Permit No. 17796

IN NAME OF

WASHINGTON COUNTY

Surveyed 6 / 23 1952, by H. J. COFFMAN