


T.2N.R.2W.W.M.

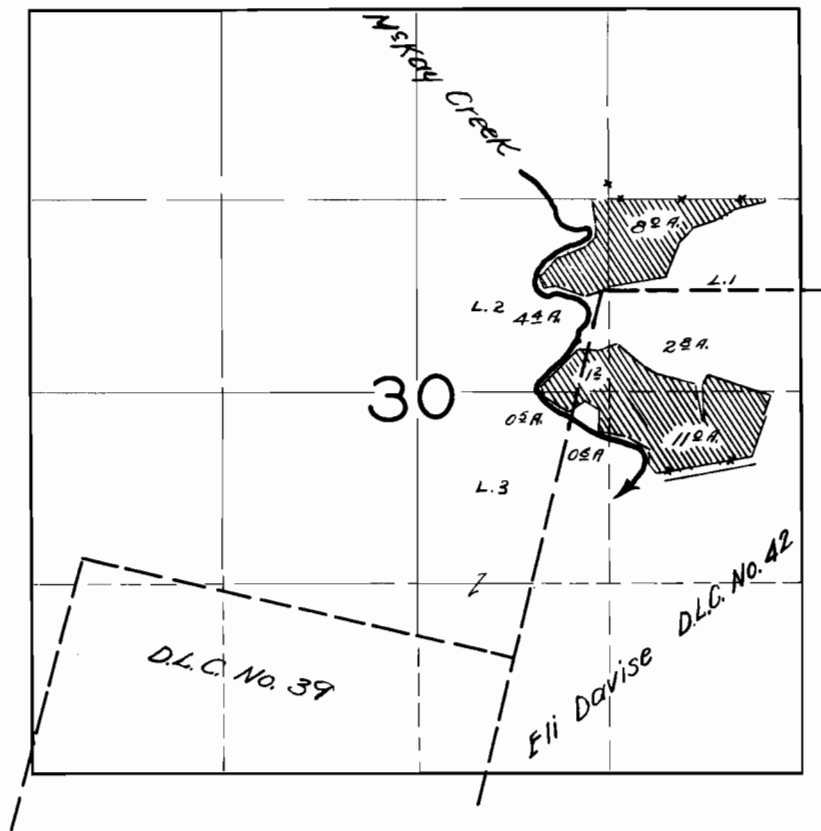

FINAL PROOF SURVEY

UNDER

Application No. 22629 Permit No. 17329

IN NAME OF

HARTMANN & WILLETT STAUSS

Surveyed 6 / 23 1952, by H. L. COFFMAN