


T. 1N.R. 4W.W.M.

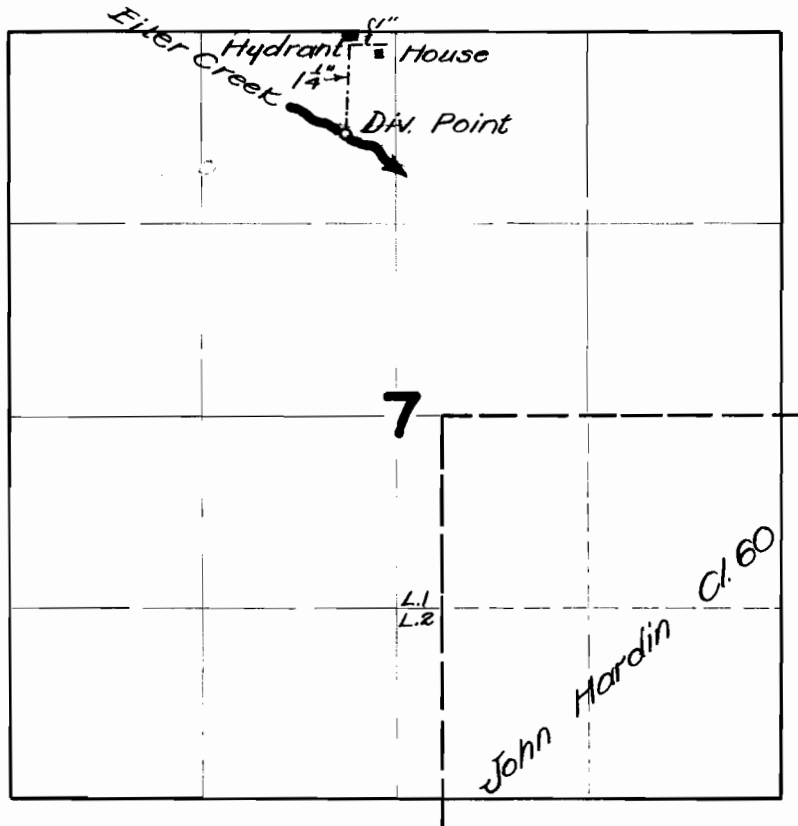

FINAL PROOF SURVEY

UNDER

Application No. 22746 Permit No. 17934

IN NAME OF

ALBERT JESSE

Surveyed 7 / 11 19 52, by H. L. COFFMAN