


T. 1 S. R. 4 W. W. M.

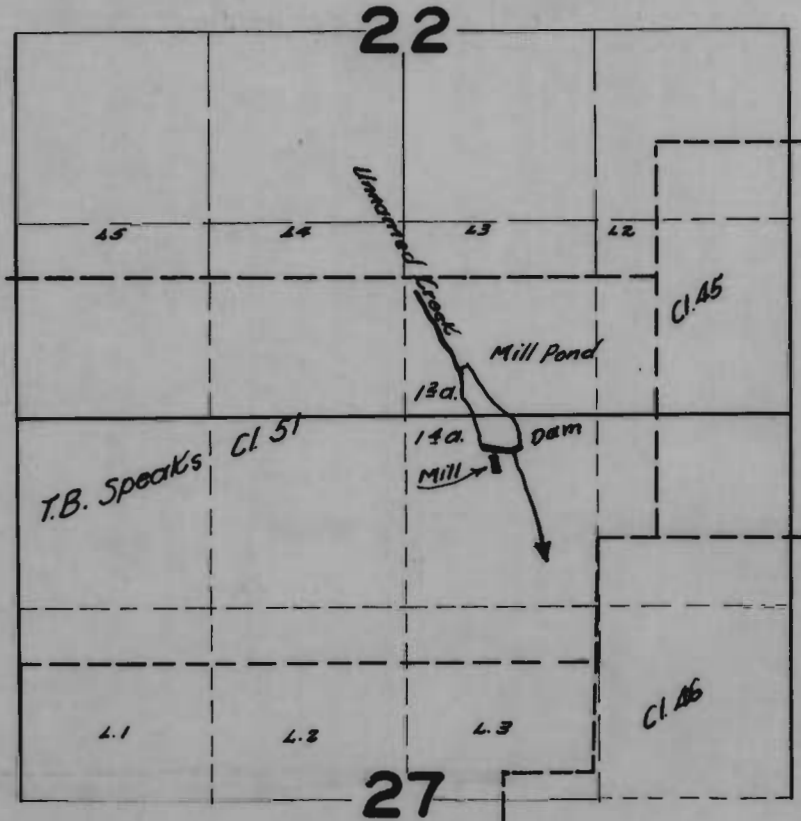

FINAL PROOF SURVEY

UNDER

Application No. 22934 Permit No. 18078

IN NAME OF

Carl Olson

Surveyed Apr. 8 1951, by H. L. Coffman