


T.I.S.R.3W.W.M.

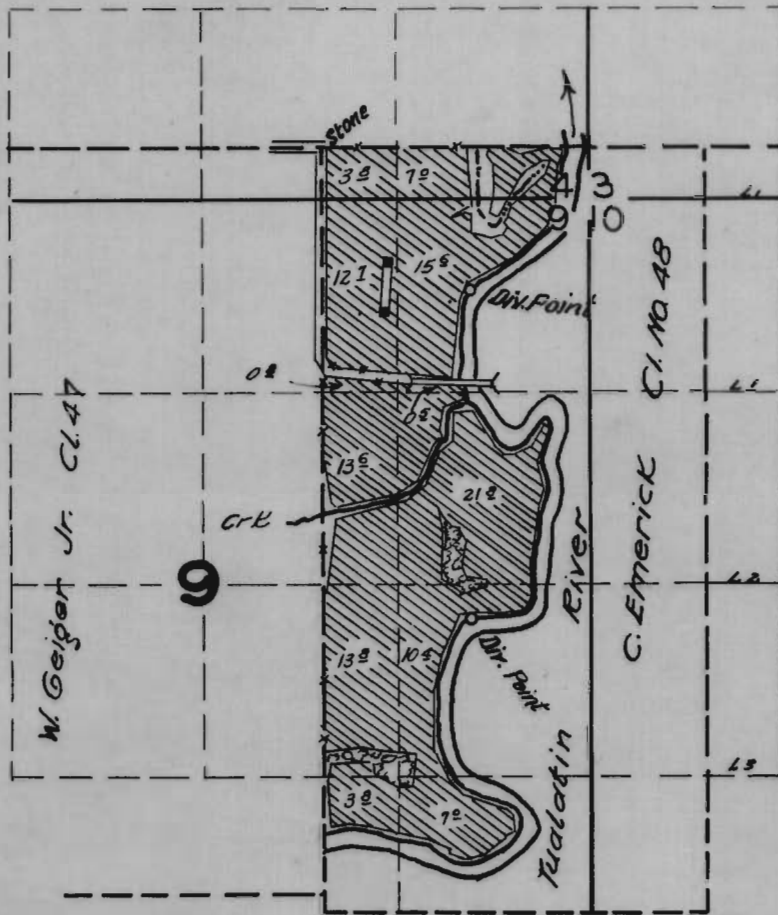

FINAL PROOF SURVEY UNDER

Application No. 23012 Permit No. 18138

IN NAME OF

HARLEY TAYLOR

Surveyed May 12, 1952, by H. L. COFFMAN