


U-230
19993

T.38S.R.1 1 1/2 E.W.M.

Buck Ar. i yanna Valley wells

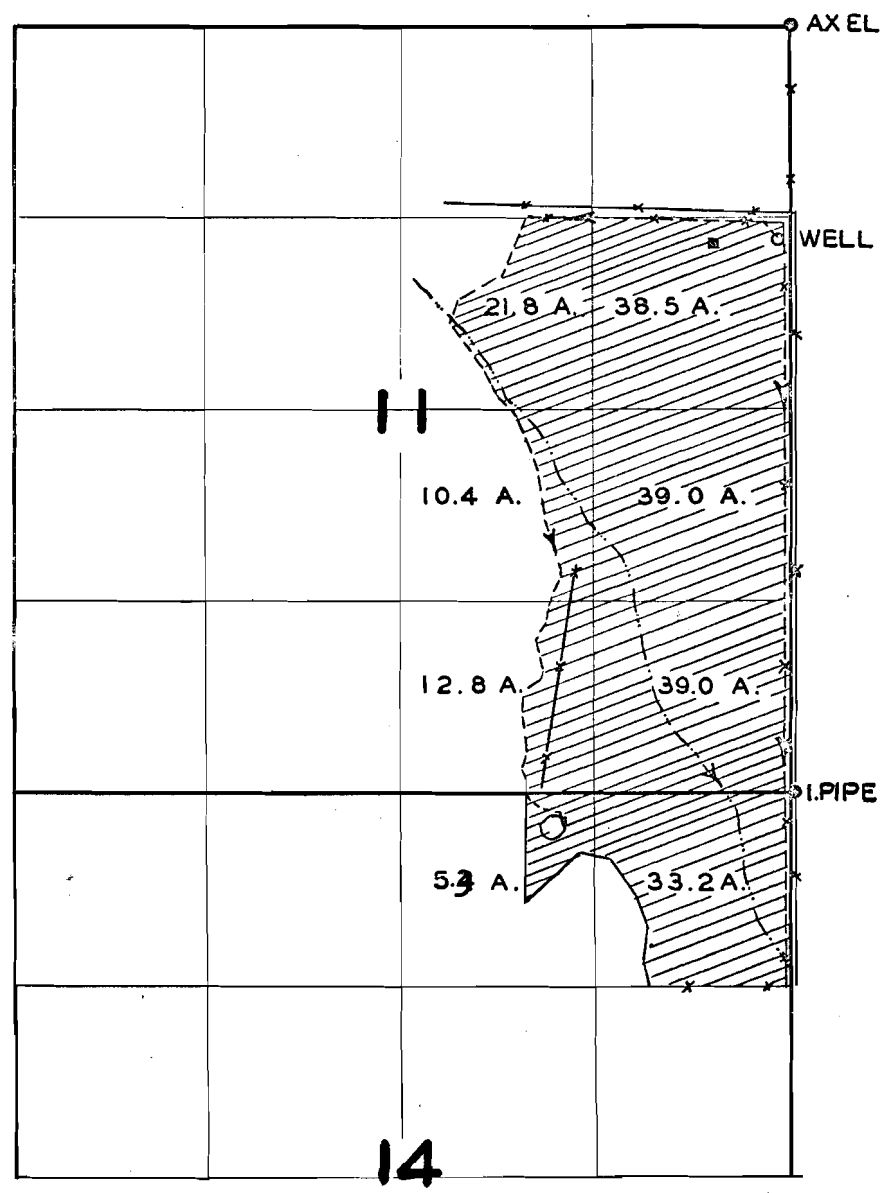

FINAL PROOF SURVEY UNDER

Application No. U-259. Permit No. U-230..
IN NAME OF

JACK C. BRADLEY

Surveyed MAY 18 1951., by H.L. COFFMAN