


T. IS. R. IW. W. M.

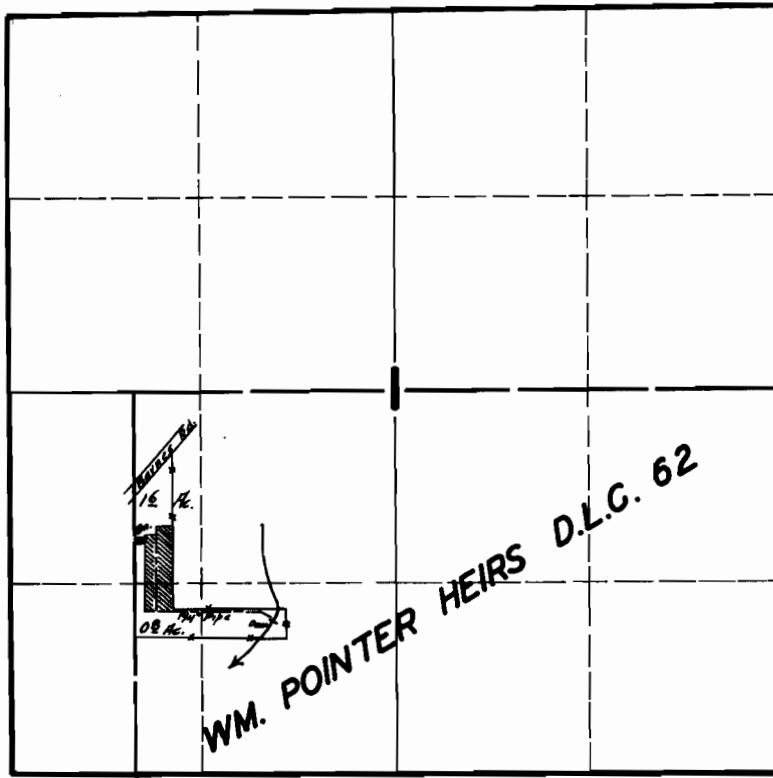

FINAL PROOF SURVEY UNDER

Application No. 1748 [] Permit No. 1319 []

IN NAME OF

WM. E. BLATTER

Surveyed AUG. 29 1945, by *[Signature]*