


T.4N.R.2W.W.M.

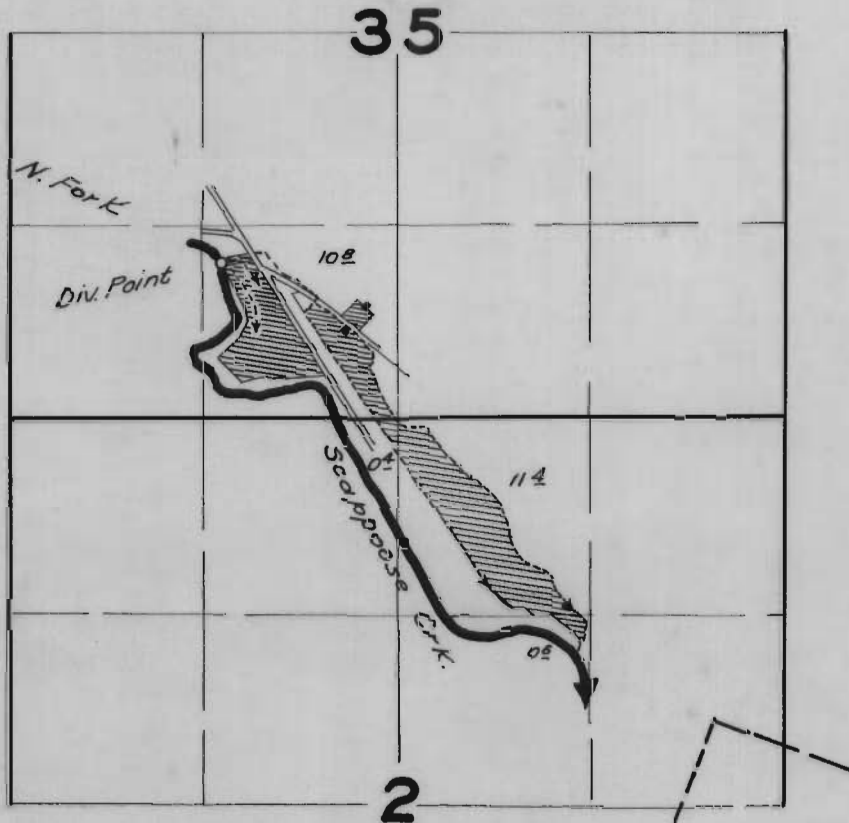

FINAL PROOF SURVEY

UNDER

Application No. 17486 Permit No. 13195

IN NAME OF

DON H. & NELL GIFT

Surveyed 7 / 24 / 1952, by H. L. COFFMAN